



**ADDENDUM 2**

**March 10, 2020**

**ITB AP 35-20**

**CONSTRUCTION OF SATELLITE CONCOURSE "C" AT VPS  
at  
DESTIN-FORT WALTON BEACH AIRPORT  
OKALOOSA COUNTY, FLORIDA**

Please find attached the Documents for the above referenced Addendum No. 2. This Addendum is hereby made a part of the Contract Documents and Specifications of the above referenced project. All other requirements of the original Contract Documents and Specifications shall remain effective in their respective order.

The purpose of Addendum No. 2 is to set forth changes and/or additional information as referenced herein.

**Note: The bidder shall acknowledge receipt of this addendum on the Bid Form, Page BF-1 in the space provided. Failure to do so may subject the bidders to disqualification.**

**Note: The ITB Opening Date & Time remains unchanged.**



MLM-MARTIN  
ARCHITECTS, INC.

## Addendum No 2

**Project:** ITB AP 35-20 Construction of Satellite Concourse "C"

---

**To:** Okaloosa County, Florida  
Board of County Commissioners  
Okaloosa County Purchasing  
Department  
5479A Old Bethel Road  
Crestview, FL 32536

**From:** MLM-Martin Architects, Inc.  
668 N. Orlando Ave, Ste. 107  
Maitland, FL 32751

**ATTN:** Jessica Darr Miguel A. Martin

---

**RE:** Addendum No 2 [Δ 2]

---

**Date:** 3/9/2020 **File:** 19672-511-10

---

ATTACHED IS ADDENDUM NO 2 TO THE SUBJECT CONTRACT DOCUMENTS. THIS ADDENDUM SETS FORTH CHANGES AND/OR ADDITIONAL INFORMATION AS REFERENCED HEREIN AND IS HEREBY MADE PART OF AND SHOULD BE ATTACHED TO THE CONTRACT DOCUMENTS. **ACKNOWLEDGE RECEIPT** OF ALL ADDENDA IN THE SPACE PROVIDED IN THE **BID FORM**. FAILURE TO DO SO MAY SUBJECT THE BIDDERS TO DISQUALIFICATION.

---

### A. Specifications:

- Item #1: Section 01 21 00 Allowances  
**MODIFIED:** Paragraph II-A to include alternates 2 and 3.  
**ADDED:** Paragraph II-B for Landscaping  
**MODIFIED:** Paragraph 3.3-A. to include Alternates 2 & 3. Addition of language to indicate prorate and provide ref to updated Bid Schedule /Form BF-8.  
**ADDED:** Paragraph 3.3B. for Landscaping.
- Item #2: Section 01 23 00 Alternates  
**MODIFIED:** Alternate 6 and 7 language to indicate prorate and provide ref to updated Bid Schedule /Form BF-8.  
**DELETED:** Alternate 8 from Schedule (Blank Alternate).
- Item #3: Section 23 00 10 Basic Mechanical Requirements.  
**MODIFIED:** paragraph 3.2-D. Removed Ref. of Pipe and Fittings.

### B. Drawings:

- Item #1: G201 -PLAN A1 - **MODIFIED** - WEST SIDE WALKS TO MATCH CIVIL SHEET UPDATES. INCLUDED FENCE "SPUR" TO THE SOUTH WEST.  
PLAN A1 - **MODIFIED** - PER OWNER DIRECTION; THE AREA OF ALTERNATE 5 WAS ENLARGED.
- Item #2: G211 -PLAN B1 - **MODIFIED** - WEST SIDE WALKS TO MATCH CIVIL SHEET UPDATES. INCLUDED FENCE "SPUR" TO THE SOUTH WEST.  
GPLAN B1 - **MODIFIED** - PER OWNER DIRECTION; THE AREA OF ALTERNATE 5 WAS ENLARGED.
- Item #3: G212 -PLAN - **MODIFIED** - INCLUDE SIDA FENCE LINE FOR CLARITY.

- PLAN - **MODIFIED** - PER OWNER DIRECTION; THE AREA OF ALTERNATE 5 WAS ENLARGED.
- Item #4: G311 -PLAN D1 - **MODIFIED** - PER OWNER DIRECTION; THE AREA OF ALTERNATE 5 WAS ENLARGED.
- Item #5: ALOO1 -**UPDATE** BUILDING AREA INFO.  
**UPDATE** BUILDING OCCUPANT LOAD INFO.
- Item #6: AL111 -PLAN D1 - **MODIFIED** - PER OWNER DIRECTION; THE AREA OF ALTERNATE 5 WAS ENLARGED.  
**UPDATE** BUILDING OCCUPANT LOAD INFO.
- Item #7: AL211 -PLAN D1 - **MODIFIED** - PER OWNER DIRECTION; THE AREA OF ALTERNATE 5 WAS ENLARGED. REQUIRED THE FLIP OF DOOR SWING.
- Item #8: AL641 -LEGEND Q & R - **ADDED** - HEIGHT MODIFIER KEY DEFINITIONS FOR USE AT TSA PODIUM.
- Item #9: C1.0 -PLAN - **MODIFIED** - WEST SIDE WALKS TO MATCH CIVIL SHEET UPDATES. INCLUDED FENCE "SPUR" TO THE SOUTH WEST.
- Item #10: C2.0 -PLAN - **MODIFIED** - WEST SIDE WALKS TO MATCH CIVIL SHEET UPDATES. INCLUDED FENCE "SPUR" TO THE SOUTH WEST.
- Item #11: C3.0 -PLAN - **MODIFIED** - WEST SIDE WALKS TO MATCH CIVIL SHEET UPDATES. INCLUDED FENCE "SPUR" TO THE SOUTH WEST.
- Item #12: A110 -PLAN D1 - **MODIFIED** - PER OWNER DIRECTION; THE AREA OF ALTERNATE 5 WAS ENLARGED.
- Item #13: A216 -PLAN B1 - **MODIFIED** - PER OWNER DIRECTION; THE AREA OF ALTERNATE 5 WAS ENLARGED.  
PLAN B4 - **MODIFIED** - TO INDICATED FULL LENGTH TRENCH DRAIN ALONG ENTRENCE OF BUILDING.
- Item #14: A316 -PLAN B4 - **MODIFIED** - TO INDICATED FULL LENGTH TRENCH DRAIN ALONG ENTRENCE OF BUILDING.
- Item #15: A500 -ELEVATION E4 - **MODIFIED** - PER OWNER DIRECTION; THE AREA OF ALTERNATE 5 WAS ENLARGED.  
ELEVATION B1- **MODIFIED** - PER OWNER DIRECTION; THE AREA OF ALTERNATE 5 WAS ENLARGED.
- Item #16: A711 -SCHEDULE W1251B - **ADDED** - PER OWNER DIRECTION; THE AREA OF ALTERNATE 5 WAS ENLARGED. NEW EGREESS ONLY DOOR REQUIRED.
- Item #17: A863 -DETAIL D5 - **MODIFIED** - TO INCLUDE CEILING CONTROL JOINT CALLOUT.
- Item #18: A865 -DETAIL C3 - **CLARIFIED** - GRAPHICS AT GATE DOOR. HIDE OF CANOPY ABOVE DOOR TO SHOW DOOR AND SWING.
- Item #19: AG111 -LEGEND - **ADDED** - FRUTIGER BOLD FONT PROVIDED FOR GRAPHICS.
- Item #20: AG112 -SHEET AG112 - **ADDED** - TO INCLUDE MATERIALS, FABRICATION NOTES FOR SIGNAGE.
- Item #21: AG512 -DETAIL ALL - **CLARIFIED** - METHOD OF ATTACHMENT.
- Item #22: AG513 -DETAIL D3 - **CLARIFIED** - SUBSTRATE MATERIALS FOR EGRESS.  
AG513 -DETAIL B1 - **CLARIFIED** - METHOD OF ATTACHMENT.
- Item #23: AG514 -SHEET AG514 - **ADDED** - TO INCLUDE FABRICATION DETAILS, NOTES & ELEVATIONS FOR SIGNAGE.
- Item #24: AQ821 -DETAIL ALL - **CLARIFIED** - WITH ADDITIONAL NOTES, MATERIAL TAGS, AND DIMENSIONAL INFORMATION.

- Item #25: AQ851 -DETAIL ALL - **CLARIFIED** - WITH ADDITIONAL NOTES, MATERIAL TAGS, AND DIMENSIONAL INFORMATION.
- Item #26: AQ852 -DETAIL ALL - **CLARIFIED** - WITH ADDITIONAL NOTES, MATERIAL TAGS, AND DIMENSIONAL INFORMATION.
- Item #27: AQ861 -DETAIL ALL - **CLARIFIED** - WITH ADDITIONAL NOTES, MATERIAL TAGS, AND DIMENSIONAL INFORMATION..
- Item #28: S002 - **REMOVED** - STRUCTURAL NOTE "4816 LINTELS."  
S002 - **ADDED** - "MASONRY" TO LIST OF REQUIRED SHOP DRAWINGS FOR ENGINEER REVIEW. *Sheet not reissued narrative of changes only.*
- Item #29: S413 - **ADDED** - KEYNOTE 9 TO LOCATION OF BID ALTERNATE EXTENTS AT REFERENCE LINE 13. *Sheet not reissued narrative of changes only.*
- Item #30: S415 - **ADDED** - KEYNOTE 10 TO LOCATION OF WALL AT REFERENCE LINE 22. *Sheet not reissued narrative of changes only.*

**C. Questions:**

- Item #1: Detail D3/AG513 indicates signage for egress. Please advise qty required. Also will this be a digital print applied decal or on a substrate?  
**A:** As indicated in the Ref. Detail "Required at each delayed egress door as indicated on Sheet AL211". "Opaque Vinyl Graphic Film: 3M Scotchcal ElectroCut Film, Series 7725, opaque, or an approved substitution" added to detail.
- Item #2: How will the There are multiple signs throughout the interior and exterior of the project. Is there a specific vendor or material that needs to be used?  
**A:** to the greatest extent possible, materials, colors and construction have been called out on details in the "AG" series of documents. Additional Fabrication and Materials notes have been provided on new sheet AG112.
- Item #3: What are the limits of Sanitary utilities for this project?  
**A:** the Sanitary Service Line and Traps shown in Drawings are in scope up to and including the tie in to existing manhole shown on C2.0.
- Item #4: Can you please advise if sign type X1 and X2 are in our scope or will that display be provided by the owner? No info can be found for type X2.  
**A:** refer to specifications §27 42 16-2.4-B.-1. - X2 Elevation provided A4/AG514.
- Item #5: Ref. Spec Section 01-43-39 To save money could you delete this section "Typical Room Mockup", as it seems un-necessary and adds to the cost of construction, is this really necessary?  
**A:** as per paragraph 3.3-A.-1. The typical room mock-up is limited to the restroom module. It is recommended that this mock-up remain as specified prior to fit out of all restrooms. Per paragraph 3.3-A. this can be a mutually agreed upon location and not excluding in-situ mock-up. It is the designer's recommendation that the family restroom to the north of the project (adjacent to the passenger screening checkpoint) be used as mock-up for tile work and integration of fixtures.
- Item #6: Specs Section 23 00 10 paragraph D page 22 talks about cleaning of equipment and piping systems and the refers to section 15060 for details. We could not locate this section. Is there one or is it a misprint/typo?  
**A:** Erroneous Reference removed see modified Specification §230010 attached.

- Item #7: Please provide additional information for sign type P. We assume this is the cast plaque in the specs?  
**A:** Assumption correct ref. specification §101416. See also A2/AG514.
- Item #8: Please indicate if the owner or the GC is the I responsible for providing the Commissioning agent for this project.  
**A:** Commissioning for HVAC as described in specification §230800 shall be included as a line item cost for owner's evaluation, consideration and acceptance. Value shall be prorated in relation to % of value of Mechanical (Division 23) work for Base Bid, Alternates 1,2,3 &5.
- Item #9: Seating allowance: how is this taken into account?  
**A:** The Seating shall be prorated across Base Bid, Alternates 1,2&3; 40%, 20%, 20%, 20% Respectfully. See Revised Bid Schedule/Form replacement Sheet BF-8 Attached.
- Item #10: How are the Alternates calculated, by seat, square foot, etc.? Is each additional gate/hold room equally segmented in price?  
**A:** Alternates 1-5 are considered lumpsum for the scope as indicated in Drawings and Specifications.  
  1. Alternate No 6; a ceiling tile substitution shall be prorated across Base Bid, Alternates 1,2 & 3 with basis of actual square footage of Tile identified for substitution. See Revised Bid Schedule/Form replacement Sheet BF-8 Attached.
  2. Alternate No 7; a wall tile substitution at bathroom vestibules shall be prorated across Base Bid & Alternates 2 with basis of actual square footage of Tile identified for substitution. See Revised Bid Schedule/Form replacement Sheet BF-8 Attached.
- Item #11: How will the fence length/price change as alternates are added? If the fence will be provided by previous contractor, how much space will be given around this project for working?  
**A:** See revised G211 and G212 indicating SIDA fence locations and 36LF to be included in base bid. Additional costs shall be listed on the revised Bid Schedule/Form BF-8 Attached for consideration. The location of construction/Temporary SIDA fence will require coordination and possible relocation by this contractor dependent on the means and methods / sequence of construction selected. The intent is to have project construction outside of the SIDA area.
- Item #12: There are landscaping specifications. How much landscaping is required?  
**A:** Landscaping shall be included in price as an Allowance for Base Bid. Ref. Section §012100 and Revised Bid Schedule/Form replacement Sheet BF-8 Attached.
- Item #13: C3.0 Fencing Plan – The fencing plans does not address the individual Bid Alternates. It only shows a plan if all alternates are taken. Please provide information for the fence scope of work for each for the base bid and each Add Alternate.  
**A:** See revised G211 and G212 indicating SIDA fence locations and 36LF to be included in base bid. Additional costs shall be listed on the revised Bid Schedule/Form BF-8 Attached for consideration.
- Item #14: Sheet AF712 – Finish Type M1 – Please provide a Color selection or provide and allowance for this block. There is a big variance in cost for color or aggregate used to manufacture these block.

- A:** As Pricing Reference: Westbrook Concrete Block – GF-302 (<https://www.westbrookblock.com/products/blacks/>) FINAL SELECTION OF COLOR TO BE DETERMINED.
- Item #15: Section 32 92 00 Turf & Grasses and 32 93 00 Plants are in the specification, but there nothing shown on the drawings for the work. Is it required?  
**A:** Yes. Landscaping shall be included in price as an Allowance for Base Bid. Ref. Section §012100 and Revised Bid Schedule/Form replacement Sheet BF-8 Attached.
- Item #16: Since the project construction fence is being provided by others, the masonry subcontractor will 50 feet of clearance down each of the long sides of the building for scaffolding and forklift access. Forklift articulating and power steering will cause damage to asphalt surfaces, which could be expensive to repair. Please take a look at providing access before paving occurs.  
**A:** The location of construction/Temporary SIDA fence will require coordination and possible relocation by this contractor dependent on the means and methods / sequence of construction selected. The intent is to have project construction outside of the SIDA area.
- Item #17: please see attached E212 to provide more info on the receptacle within a square – the symbol is not on any legend and not in the specs. If they are floor boxes, please provide the basis of design.  
**A:** See Revised E000 **ISSUED ADDENDUM 001** for definition of Symbol.
- Item #18: Please provide more info/schedule for the Main Switchgear and UPS. They are shown on the Single Line Diagram on E501, but have no schedule.  
**A:** See Revised electrical drawings **ISSUED ADDENDUM 001** for clarification on Switchgear and UPS.
- Item #19: E604 states A1- fixtures are 8ft fixtures, A2- fixtures are 4ft. Sheets E311-E316 show A1 fixtures like 4ft fixtures, and A2 fixtures like 8ft fixtures. Please confirm.  
**A:** E604 Shall be revised to indicate A1 Fixtures as 4FT (N2LEDG29LK48) and A2 Fixtures as 8FT (N2LEDG43LK96). Plans E311-E316 unchanged.
- Item #20: Electrical Sheets scale- 3/16"? Please confirm this is the correct scale.  
**A:** Confirmed.
- Item #21: Are mounting details for all ceiling signs and flag signs available?  
**A:** to the greatest extent possible, materials, colors and construction have been called out on details in the “AG” series of documents. Additional Fabrication and Materials notes have been provided on new sheet AG112 and notations added to revised “AG” drawings attached.
- Item #22: Supervisory Tone for Paging Amp monitoring: Is this a non-waiver-able requirement or can this be disregarded as an unnecessary option. It will add significant cost and add no additional benefit other than to know if an amp fails.  
**A:** Contractor shall separate the cost as an add alternate line item for owner review.
- Item #23: Microphones on Drawings: The Microphones as specified are for the PageMatrix system. I would like to substitute them with the MediaMatrix PCU-3 Microphone Station.

- A:** Contractor shall provide a submittal with the proposed PCU-3 Microphone Station data sheet for review.
- Item #24: Page Zones: The current Page Zone divisions do not address a separate and independent Concourse Page zone. This presents several problems among the current Gate Page zones. The only way to address someone on the concourse proper would be to do an 'All Page', and hope no other gate was using their mic.
- A:** There are currently 6 separate paging zones dedicated for the new Concourse. Drawings will be updated in Addendum #2 to reflect a dedicated Concourse all page.
- Item #25: Ambient Sense Mics: There is an excessive number of Ambient Mics in all of the Page Zones. This impacts the input CABs heavily by using up unnecessary inputs. Suggest an alternative 'Sub-Mixing' scheme for the Mics or reduce the number of mics to one in each zone of control.
- A:** Drawings will be updated in Addendum #2. Contractor shall account for Ambient Mics quantities for the following sheets.
- TP212 = (3) Ambient Mics
  - TP213 = (2) Ambient Mics
  - TP214 = (1) Ambient Mics
  - TP215 = (3) Ambient Mics
  - TP216 = (2) Ambient Mics
- Item #26: Zone Paging Amplifiers: The TOA Amplifiers specified for the system are very good amplifiers. I/O count on the Cobra devices can be conserved by switching to a Peavey Brand Cobra ready amplifier. Traffic can be routed directly to them and free up I/O count on the CABs and allow for expansion and items mistakenly left out that would require a precious route back to the head-end. Can an alternative Peavey CobraNet Amp be used in lieu of the TOA amp?
- A:** Contractor shall provide a submittal with the proposed amplifier data sheet for review.
- Item #27: CobraNet and LAN: The CobraNet needs to be on a separate and isolated network from the other LAN systems. The audio traffic on this network is proprietary to the type of information being sent and received on it.
- A:** Drawings will be updated in Addendum #2 drawings.
- Item #28: Section 1.2 Part B states "Shall be part of the MediaMatrix family of products". Later in the document several IED GlobalCom products are referenced. Both systems have their own proprietary software and can be physically integrated but can only be controlled by its own software package. Please see references as listed below for in question:
- Section 1.9 Extra Material Part B-2 has an IED T6472L part number listed as a spare amplifier module. This part will not work in a Peavey (Crest) CI 30x4 Amplifier (listed as no approved equal in Section 2.3 Part E-7) as it is not a modular design. It is designed to work in an IED T9160L digital amplifier frame, but this frame has been discontinued. The current modular digital amplifier frame is the IED Titan T112. This digital amplifier frame meets all specifications but it does not belong to the MediaMatrix family of products.
- Section 2.2 System Performance Part-B System Architecture has an alternate listed "the vACS and optional Enterprise and MS SQL may be installed in virtualized environment for high availability architecture. Failed or

abnormal performance of any active system component shall generate a fault to the fault reporting system". Enterprise software is an IED product that resides on a GlobalCom server that monitors critical system functions and generates a fault to the log. This fault would need to be investigated and then could be suppressed. This function is not available on the MediaMatrix family of products. Section 2.2 System Performance Part-R Automatic Backup Amplifier Switching states "the system shall include backup amplifier switching in the event of the failure of the power amplifier". This function is not available on the Peavey (Crest) CI 30x4 amplifier but is standard on the IED Titan T112 amplifier series. Section 2.2 System Performance Part-S states "provide a dynamic multi-channel VU monitoring screen selectable for each T9160 Mainframe" The IED T9160L is not a MediaMatrix product and has been replaced by the IED Titan T112 Mainframe which is also not a MediaMatrix product. The T112 provides full monitoring capabilities, has a modular amp card design and has standard back up amp capabilities as well as ambient analysis capabilities built in as standard features. Section 2.3 System Performance Part-A-3 states "for each IED 1150 server, provide a backup IED 1150 Lifeline backup server". IED products are not from the MediaMatrix family of products and are the primary controllers for IED GlobalCom systems. If an IED GCK Airport paging system were installed these features and more would be available. Section 2.3 System Performance Part-D mentions the "Bogen ANS501 Ambient Analysis Sensor" . If a fully digital system from controller to amplifier outputs is installed. The Bogen unit, which is analog and unbalanced, would have no place to be inserted in the signal chain. The IED Titan T112 has ambient sensing standard and built into the frame. It requires one CAT-6 connection and can handle (12) sensors per frame.

**A:** Peavey Media Matrix is an extension of the existing system. Proprietary software and hardware shall be Peavey products. IED amplifiers, software and components shall be excluded from the package. This system is an extension of an existing Peavey paging system and all products shall follow suit.

Item #29: Ref. Spec Section 26-24-13 Switchboard Test Fld Quality Control 3.5 Will the factory testing and U/L Cert qualify for this section or will a 3rd party testing lab be required and to do on site? This seems costly and un-necessary, please advise?

**A:** The testing listed in the referenced paragraph is not a laboratory test. These items are specific to acceptance of the full installation and are required inclusive of IR Arc Flash testing of the completed install.

Item #30: Ref. Spec Section 26-28-16 1.6 Quality Assurance Is there any need for a testing agency to field supervise and be on site? If so, please provide 3-companies and contacts so we can get quotes for this service.

**A:** For pricing assume required; may be possible consideration for value engineering evaluation by owner. The specification is open to any NETA qualified individual- specifically listing 3 would close the ability to have open bid. For more information visit <https://www.netaworld.org/about/why-hire-nacs> .

Item #31: Ref all Spec. Sections on Electrical Field Quality Control 3.6 All of this seems un-necessary, excessive and costly, are these requirements truly needed?

- A:** For pricing assume required; may be possible consideration for value engineering evaluation by owner.
- Item #32: Ref Spec Section 26-36-00 Transfer Switches Does this section apply? I've not found any Transfer Switches or Generators on this project, please advise if applicable or not
- A:** Yes scope clarified in edits to Electrical Drawings per **ADDENDUM 001**
- Item #33: Ref Spec Section 27-05-00-55 items 5, 6, and 7 This items seem excessive and un-necessary due to the fact that there is currently no badging requirements, however once the Concourse is open, up and running there will be badging requirements. Also, to do these tests and inspections, these work if required will be disruptive to Airport Operations. Is this section required?
- A:** All items required. Although the construction is intended to be outside of the SIDA area, upon start-ups, close out and completion of the project the Concourse will act like any other terminal/concourse project with active access to the SIDA as such a fully operational, tested and vetted PACS system is required.
- Item #34: Ref Spec Section 27-05-00 3.13 Training This section seems excessive and un-necessary for just a Concourse of this nature. Is this required?
- A:** For pricing assume required; may be possible consideration for value engineering evaluation by owner. These systems are to be integrated into the existing airport complex; although staff may have familiarity with the system these integrations must be complete and staff have full understanding of them.
- Item #35: Ref Spec Section 27-05-00 IPTV Distribution System Is this section required?
- A:** Required, See updates to T sheets per **ADDENDUM 001**.
- Item #36: Ref Spec Section 27-42-16 MUFIDS Is this section required?
- A:** Required, reference sign types X1 and X2 in AG series drawings. System includes FIDS and GIDS
- Item #37: Ref Spec Section 28-05-00 Electronic Safety and Security Is this section required?
- A:** Required, reference appropriate scope on T and TS sheets.
- Item #38: The Fire Alarm is said to be Siemens, please provide a contact phone number, or any ID number and name for us to call and get pricing as Siemens would be the only compatible system to provide on this project. Please advise?
- A:** Contact information  
 Paul Lehr Paul.lehr\_sr@siemens.com  
 Sr. Systems Specialist  
 Siemens - Building Technologies  
 850-206-0686

**D. Other Items:**

- Item #1: BID SCHEDULE/FORM REPLACEMENT SHEET BF-8.
- Item #2: Structural DETAIL SK0-1 - ADDED - "TYPICAL STEPPED TIE BEAM DETAIL."
- Item #3: Substitution Request received for Sika Single Ply roofing was received after deadline and was not reviewed.

End of Addendum No 2

## SECTION 01 21 00 - ALLOWANCES

### PART 1 - GENERAL

#### 1.1 RELATED DOCUMENTS

- A. Drawings and General Conditions/Provisions of the Contract, including Contractual Conditions and other Division 1 Specification Sections, apply to this Section.

#### 1.2 SUMMARY

- A. This Section includes administrative and procedural requirements governing allowances.
- B. All applicable allowances are included in the Total Amount Bid.

#### 1.3 SCOPE, SELECTION AND PRICING

- A. For each Work item covered by an allowance, the Contractor shall submit a Request for Change Order (RCO) at the earliest practical date after award of the Contract. The RCO shall include the scope of work, the schedule and the amount of allowance to be used for the Work item. The RPR will process a Contract Modification for the Work item in accordance with the terms of the General Conditions/Provisions and the Owner's policies regarding approval authority. Note that the General Conditions/Provisions outlines the various types of Contract Modifications as well as various methods of payment, including Force Account provisions.
- B. At the RPR's request, obtain proposals for each applicable allowance item for use in making final selections. Include recommendations that are relevant to performing the Work.
- C. Purchase products and systems selected by the RPR. Do not begin Work on an item covered by an allowance until a Contract Modification has been authorized by the Owner.

#### 1.4 SUBMITTALS

- A. General: Submit proposals for the work included in allowances, in the form specified for Change Orders.
  - 1. Submit invoices or delivery slips to show the actual quantities of materials delivered to the site for use in fulfillment of each allowance.
  - 2. Submit cut sheet, manufacturer's data, shop drawings and samples for products selected per Sec. 01 33 23 Shop Drawings, Product Data and Samples.

#### 1.5 ALLOWANCES

- A. Use the allowance only as directed by the RPR or Owner for the Owner's purposes. The inclusion of allowances in the Contract is not a guarantee that payment will be made for the full amount of the allowance unless the Owner has determined there has been full compliance with the Contract Documents for each allowance.
- B. Allowances shall only include the Contractor's direct costs and mark-up in accordance with the Changes in the Work Article of the General Conditions/Provisions.

#### 1.6 UNUSED ALLOWANCES

- A. At Project close-out, credit all unused allowance monies to the Owner by Change Order.

#### PART 2 - PART 2 - PRODUCTS

- A. \$125,000.00 for Hold Room seating as shown on drawing for Base Bid and Alternate No. ~~1~~ **1, 2 & 3.** seating manufacturer and seating system type, color and fabric to be selected by Architect from seating manufacturers catalog.
- A.B. \$40,000.00 for Landscaping as provided for in specifications. Base Bid only.**

#### PART 3 - PART 3 - EXECUTION

##### 3.1 EXAMINATION

- A. Examine products covered by an allowance promptly upon delivery for damage or defects. Report findings and proposed corrective action to the RPR in writing.

##### 3.2 PREPARATION

- A. Coordinate all work for each allowance with related materials and installations to ensure that each allowance item is completely integrated and interfaced with related work.

##### 3.3 SCHEDULE OF ALLOWANCES

- A. Hold Room seating, Base Bid and Alternate No. ~~1~~ **1,2 & 3** in amount \$125,000.00 **to be prorated 40%, 20%, 20% & 20% respectively. See Bid Schedule/Form Sheet BF-8.**
- A.B. Landscaping, Base Bid Only in amount of \$40,000.00**

END OF SECTION 01 21 00

## SECTION 01 23 00 - ALTERNATES

### PART 1 - GENERAL

#### 1.1 RELATED DOCUMENTS

- A. Drawings and General Conditions/Provisions of the Contract, including Contractual Conditions and other Division 1 Specification Sections, apply to this Section.

#### 1.2 SUMMARY

- A. This Section includes administrative and procedural requirements governing Alternates.

#### 1.3 DEFINITIONS

- A. Definition: An alternate is an amount proposed by bidders and stated on the Bid Form for certain work defined in the Bidding Requirements that may be added to or deducted from the Base Bid amount if the Owner decides to accept a corresponding change in either the amount of construction to be completed, or in the products, materials, equipment, systems, or installation methods described in the Contract Documents.

- 1. The cost or credit for each alternate is the net addition to or deduction from the Contract Price to incorporate the Alternate into the Work. No other adjustments are made to the Contract Price.

#### 1.4 PROCEDURES

- A. Coordination: Modify or adjust affected adjacent work as necessary to completely and fully integrate that work into the Project.
  - 1. Include as part of each alternate, miscellaneous devices, accessory objects, and similar items incidental to or required for a complete installation whether or not mentioned as part of the Alternate.
- B. Notification: The Owner will notify each party involved, in writing, if alternates have been accepted, rejected, or deferred for later consideration.
- C. Schedule: A schedule of alternates is included in the Bid Form. Specification Sections referenced in the Schedule contain requirements for materials necessary to achieve the Work described under each alternate.

### PART 2 - PRODUCTS (Not Applicable)

PART 3 - EXECUTION

2.1 SCHEDULE OF ALTERNATES:

**BASE BID: Construction of:**

To the extent shown on drawings and specifications, see sheets G-2.1.1 & G-2.1.2.

**Alternate #1 : Construction of:**

To the extent shown on drawings and specifications, see sheets G-2.1.1 & G-2.1.2.

**Alternate#2: Construction of :**

To the extent shown on drawings and specifications, see sheets G-2.1.1 & G-2.1.2.

**Alternate #3: Construction of :**

To the extent shown on drawings and specifications, see sheets G-2.1.1 & G-2.1.2.

**Alternate #4: Covered Walkway**

To the extent shown on drawings and specifications, see sheets G-2.1.1 & G-2.1.2.

**Alternate #5: Outdoor Seating area :**

To the extent shown on drawings and specifications, see sheets G-2.1.1 & G-2.1.2.

**Alternate #6 : Substitution of ACT1: prorated addition to Base Bid, Alternates 1,2 & 3**

To the extent shown on drawings and specifications. "CALLA" HIGH CAC 50 24" X 24" x 1 3/4" Ceiling Tile for ACT1, See AF712 \*\* Prorate basis on Square Feet of Tile Substituted see BF-8.

**Alternate #7 : Substitution of GT1 & GT2: prorated deduction to Base Bid and Alternate 2**

To the extent shown on drawings and specifications. CT2 for GT1 and GT2, See A45X SERIES & AF712 \*\* Prorate basis on Square Feet of Tile Substituted see BF-8.

~~**Alternate #8 : Construction of:**~~

~~To the extent shown on drawings and specifications.~~

END OF SECTION 01 23 00

01 23 00 - 2

## SECTION 23 00 10 - BASIC MECHANICAL REQUIREMENTS

### PART 1 - GENERAL

#### 1.1 RELATED DOCUMENTS

- A. Drawings and general provisions of the Contract, including General and Supplementary Conditions and Division 01 Specification Sections, apply to this Section.
- B. This specification section is applicable to all division 23 specification sections.

#### 1.2 SUMMARY

- A. Mechanical systems, equipment, devices and accessories shall be installed, finished, tested and adjusted for continuous and proper operation. Any apparatus, material or device not shown on the Drawings but mentioned in these Specifications, or vice versa, or any incidental accessories necessary to make the project complete and operational in all respects, shall be provided. Include all materials, equipment, supervision, operation, methods and labor for the fabrication, installation, start-up and tests necessary for complete and properly functioning systems.

#### 1.3 MECHANICAL SYSTEMS DESCRIPTIONS

- A. Basic Design Criteria
  - 1. The following publications will be used as a reference for design of the mechanical systems:
    - a. Florida Building Code 6<sup>th</sup> Edition (2017)
    - b. Florida Building Code: Mechanical 6<sup>th</sup> Edition (2017)
    - c. Florida Building Code: Energy Conservation 6<sup>th</sup> Edition (2017)
    - d. Florida Building Code: Plumbing 6<sup>th</sup> Edition (2017)
    - e. ASHRAE 62.1-2013
    - f. ASHRAE 90.1-2016
    - g. ASHRAE 15-2013
    - h. SMACNA
- B. Climate Design Criteria (ASHRAE Handbook – Fundamentals (2017))
  - 1. Summer Outside:
    - a. 93.9°F DB
    - b. 77.5°F WB
  - 2. Winter Outside:

- a. 30°F DB
3. ASHRAE Climate Zone: 2A
- C. Envelope Design Criteria:
  1. Walls:
    - a. Mass Walls: R-5.7 continuous insulation
    - b. Metal Framed Walls: R-13 insulation between framing
  2. Roof: R-25 continuous insulation
  3. Glazing
    - a. Windows: U-0.5 SHGC-0.25
    - b. Skylights: U-0.65 SHGC-0.35
- D. Building Occupancy Schedule:
  1. It is understood that this facility will sustain 24/7 operation.
- E. Indoor Design Criteria:
  1. Offices: Cooling
    - a. Occupied: 74°F
    - b. Unoccupied: 80°F
  2. Offices: Heating
    - a. Occupied: 70°F
    - b. Unoccupied: 60°F
  3. Holdrooms: Cooling
    - a. Occupied: 72°F
    - b. Unoccupied: 80°F
  4. Holdrooms: Heating
    - a. Occupied: 72°F
    - b. Unoccupied: 60°F
  5. Electrical/Mechanical Rooms: Cooling
    - a. Occupied: 78°F
    - b. Unoccupied: 78°F

6. IDF/MDF Spaces: Cooling
    - a. Occupied: 74°F
    - b. Unoccupied: 74°F
  7. Concession Spaces: Cooling
    - a. Occupied: 72°F
    - b. Unoccupied: 80°F
  8. Concession Spaces: Heating
    - a. Occupied: 72°F
    - b. Unoccupied: 60°F
  9. Corridors: Cooling
    - a. Occupied: 72°F
    - b. Unoccupied: 80°F
  10. Corridors: Heating
    - a. Occupied: 72°F
    - b. Unoccupied: 60°F
  11. TSA/Security Checkpoints: Cooling
    - a. Occupied: 72°F
    - b. Unoccupied: 80°F
  12. TSA/Security Checkpoints: Heating
    - a. Occupied: 72°F
    - b. Unoccupied: 60°F
- F. Ventilation Requirements and Building Air Balance:
1. Ventilation outside Air shall be in accordance with ASHRAE 62.1.
  2. The balance between outside air and exhaust air will result in a positively pressurized building when in occupied periods.
- G. Filtration:
1. RHU's:
    - a. Pre-Filters: 4" 30% ASHRAE efficient filters (MERV 8)
    - b. Final Filters: 12" Cartridge 90% ASHRAE efficient filters (MERV 13)

2. FCU's:
    - a. Filters: 4" 30% ASHRAE efficient filters (MERV 8)
  3. Filters shall be industry standard sizes.
  4. Filter frames shall be galvanized sheet metal with spot welds or fully welded.
- H. The new is designed as an approximate 42,000 s.f. single story Airport Concourse facility with mechanical mezzanines. Preliminary load calculations have been conducted to determine rough HVAC equipment sizing.
- I. Packaged DX Rooftop Units (RTU) shall be provided on the roof and will condition the Office spaces, Hold Rooms, and TSA/Security Checkpoints. The RTUs shall have DX cooling coils and electric re-heat coils. The RTU's will utilize VAV terminal units for zone control will have electric heat within the VAV terminal units.
1. RTUs shall have the following configuration:
    - a. Mixing box section
    - b. Filter section with 4" pre-filters and 12" final-filters
    - c. Access Section
    - d. DX coil.
    - e. Access Section
    - f. Plenum supply fan array (Minimum 2 supply fans in array)
    - g. Electric Heat Coil
    - h. Discharge Plenum
  2. Solid Double wall construction (MFG guaranteed non-condensing thermal performance), set on concrete pad, with internal spring isolated fans (minimum 2" deflection spring isolation, and neoprene pad below.)
  3. Coil shall be 12 FPI max.
  4. Cooling coils shall be sized for 52 degree LAT.
  5. Condensate drains shall be stainless steel.
  6. Coil casings shall be stainless steel.
  7. Control Dampers will have airfoil blades with blade seals.
  8. Motors shall be provided with AEGIS shaft grounding rings, factory installed, for all motors served from VFD's.
- J. Building Ventilation air shall be induced directly into the RTU's intake hood. Outside air paths will be monitored by airflow monitoring stations (Ebtron Gold or approved equal) for airflow tracking and proper building pressure control.
- K. Building general exhaust shall be provided by roof mounted centrifugal downblast exhaust fans located on the roof.
- L. Building Heating will be provided by electric heaters at each RTU. For RTUs with VAV terminal units, electric reheat shall be provided at the terminals (VTUs), with SCR control, sized to meet building heating demands.

- M. Temperature critical spaces which require continual cooling such as IT/Data rooms shall be provided with dedicated VAV terminal units and a Split-DX backup system for redundancy.
- N. Supply and return air ductwork will be externally insulated galvanized steel when routed above ceilings, and would be double wall round if exposed. All ductwork to be insulated in concealed areas shall be fiber blanket type, all insulated ductwork exposed in mechanical spaces shall be rigid board insulation.
- O. All ductwork shall be formed from galvanized steel and shall conform to the requirements of SMACNA's Duct Construction Standards, NFPA Standard 90A. All supply ductwork shall be externally wrapped with 2 inch fiberglass insulation with FSK vapor barrier. Return and exhaust ductwork shall be constructed per low pressure supply ductwork standards, except that they will not be insulated except as required by the International Energy Code. Fire dampers and combination fire/smoke dampers will be installed at all ductwork penetrations of rated fire and smoke walls/partitions and shafts as shown on the architectural floor plans. Seal all ductwork (supply, return and exhaust) in accordance with the International Energy Code. Do not use snap lock construction.
1. Low pressure ductwork will be designed from the terminal units (VTU) to the diffusers/grills, RA ductwork, and exhaust ductwork. Low pressure ductwork will be sized to deliver air at a friction pressure drop not to exceed 0.08"w.c. per 100' of duct. (i.e. Air Duct Calculator)
  2. Medium pressure ductwork will be designed from the VAV AHU to the terminal units (VTU). Medium pressure ductwork will be sized to deliver air at a friction pressure drop not to exceed 0.2"w.c. per 100' of duct or no more than 2000 FPM (Max 1500 FPM in acoustic sensitive locations.). (i.e. Air Duct Calculator)
- P. Exhaust ductwork shall be un-insulated galvanized steel.
- Q. The complete air and water system will be tested, adjusted and balanced by an independent certified testing and balancing firm (NEBB or AABC) as required to ensure system performance in accordance with design criteria.
- R. A direct digital control (DDC) building automation system (BAS) shall be provided. All HVAC mechanical devices will be interfaced with the BAS for control, monitoring and alarm. A centrally located operator's computer workstation will be provided for BAS reference and adjustment. Siemens is the owner preferred controls manufacturer.
1. All air-handling units and other major equipment shall use DDC with stand-alone panels for each unit.
  2. Provide Optimized start/stop scheduling, occupied/unoccupied set-points, Night set-back, Schedule control, Static pressure reset schedules, SA reset schedules, OA flow monitoring/control, Relief Airflow monitoring/control, VFD's on all fans other than small CV general exhaust.
  3. All cooling and heating coils shall have Discharge air temperature sensors for monitoring performance.
  4. Damper actuators shall be DDC.

5. Control valves shall be pressure independent Characterized ball control valves with stainless steel stems and balls.
  6. Control sequences shall comply with ASHRAE 90.1.
- S. UL555s Combination Fire Smoke Dampers, UL555 Fire Dampers, and UL555s Smoke Dampers shall be provided in accordance with FBC/FMC.
- T. Air distribution shall be supplied through diffusers located in acoustical ceiling tile or drywall ceiling, at ceiling level. Ceiling return grilles shall transfer the supplied air to the return air system. It is anticipated that the following grilles/diffusers will be incorporated in the design.
1. 24x24 Lay-In Architectural Plaque Diffuser
  2. 12x12 Surface Mounted Plaque Diffuser
  3. 1 to 3 slot diffusers  $\frac{3}{4}$ " slot – (High Ceiling Areas / Perimeters)
  4. Perforated Return Grilles
  5. Louvered Return Grilles (i.e. Sidewall)
  6. Louvered Supply Grilles (i.e. Sidewall)
  7. Supply Nozzles (High Volume Spaces such as Hold Rooms and TSA/Security Checkpoints)
- U. Intake Louvers sized for 500 FPM at free area, and exhaust louvers shall be sized for 750 FPM at free area. Louvers will be specified to be AMCA 540/550.
- V. Commissioning:
1. The building will be commissioned to meet the design intent of the drawings. Contractor shall provide all required labor and material to support commissioning process. Contractor shall provide labor to complete testing of systems under the direction of the commissioning authority.
  2. Commissioning shall be provided to meet code minimum commissioning requirements.
- 1.4 QUALITY ASSURANCE
- A. Code Compliance: Comply with all rules, laws, statutes, regulations, building codes, and the amendments of local, state and federal governments by the authorities having jurisdiction.
- B. ADA: Comply with the requirements of the Americans with Disabilities Act (ADA).
- C. HANDICAP ACCESS: Comply with Chapter 553, Part II, Florida Statutes, "ACCESSIBILITY BY HANDICAP PERSONS"; and the accessibility requirements manual from the Florida Board of Building Codes and Standards, Department of Community Affairs, latest Revisions.

- D. NFPA: Comply with the National Fire Codes compiled by the National Fire Protection Association.
- E. Florida Building Code: Conform in strict compliance to the current editions of Florida Building Code; Florida Mechanical Code; Florida Energy Efficiency Code, Florida Plumbing Code; Florida Fuel Gas Code; and the amendments to these codes which are enforced by the local authority having lawful jurisdiction.

#### 1.5 DRAWINGS AND SPECIFICATIONS

- A. Equipment Placement: The drawings are diagrammatic, intended to show general arrangement, capacity and location of various components, equipment and devices. Reasonable changes in locations ordered by the Engineer prior to the installation may be made at no additional cost.
- B. Drawing Scale: Due to the small scale of the drawings, and to unforeseen job conditions, all required offsets, transitions and fittings may not be shown but shall be provided at no additional cost.

#### 1.6 DEFINITIONS

- A. Concealed: When standing inside a finished room, insulated or non-insulated piping or ductwork not visible after installation, such as inside a chase or above a ceiling.
- B. Exposed: When standing inside a finished room, insulated piping or ductwork is visible after installation, such as inside an equipment room or an air handling unit room.
- C. Protected: The surface of insulated or non-insulated piping or ductwork on the exterior of the building but protected from direct exposure to the weather by an overhang, eave, in an unconditioned parking garage or building crawl space.
- D. Unprotected: The surface of insulated on non-insulated piping or ductwork on the exterior of the building and exposed to the weather.

#### 1.7 SUBMITTALS

- A. Shop Drawings: Shop drawings include piping system layouts, ductwork layouts, fabrication and installation drawings of supports and anchorage for mechanical materials and equipment, and coordination drawings. Shop drawings also include proposed equipment layouts, drawn to scale, indicating that proposed equipment will fit into allotted space, including service access, connections, etc.
  - 1. Piping Systems: See Specification 232113 HYDRONIC PIPING. Submit shop drawings for piping systems drawn at a minimum scale of ¼ inch per foot to verify clearances and equipment locations. Show required maintenance and operational clearances. Include the following:

- a. Architectural and structural backgrounds with room names and numbers, including but not limited to plans, sections, elevations and details.
  - b. Fabrication and erection dimensions.
  - c. Arrangements and sectional views.
  - d. Details, including complete information for making connections to equipment.
  - e. Descriptive names of equipment.
  - f. Modifications and options to standard equipment required by Contract Documents.
  - g. All in ground: Electrical Boxes, plumbing, mechanical, valve boxes or similar.
2. Ductwork: See Specification 233113 METAL DUCTS. Submit shop drawings for duct systems at a minimum scale of 1/4 inch per foot to verify clearances and equipment locations. Show required maintenance and operational clearances. Include the following:
- a. Architectural and structural backgrounds with room names and numbers, etc., including but not limited to plans, sections, elevations, details, etc.
  - b. Fabrication and erection dimensions.
  - c. Arrangements and sectional views.
  - d. Details, including complete information for making connections to equipment.
  - e. Materials and finishes.
  - f. Descriptive names of equipment.
  - g. Modifications and options to standard equipment required by Contract Documents.
3. Coordination Drawings: Submit coordination drawings including detailed drawings showing locations and positions of all Architectural, structural, plumbing, fire protection, electrical and mechanical elements. Drawings shall be minimum ¼ inch per foot for each mechanical equipment room, mechanical riser, or chase. All other areas shall be a minimum 1/8 inch per foot. Including but not limited to the following:
- a. Refer to 230010-1.7 below for additional coordination drawing requirements.
  - b. Architectural and structural backgrounds with room names and numbers, etc., including but not limited to plans, sections, elevations, details, etc.
  - c. Show all trades coordinated and signed off by all trades prior to submitting.
  - d. Show all required maintenance and operational clearances.
  - e. Show all required access doors, proposed door types, door finishes, and sizes for Architect review. (Walls, Floors Ceilings...)
  - f. All in ground: Electrical Boxes, plumbing, mechanical, valve boxes or similar.
4. All overhead equipment requiring access for maintenance and replacement shall have a clear vertical space from the equipment to the floor, excluding removable ceiling tiles. The clear vertical space shall also include the space required for equipment access from a ladder. This overhead equipment shall include but not be limited to air terminal units, exhaust fans and valves. Contractor shall coordinate with all trades to ensure this clearance is maintained; as this clearance area shall not be infringed upon by any equipment including conduit, wiring, piping or ceiling

- grid support wires. (No equipment shall be over 16'AFF, and all equipment shall be accessible with no more than a standard 10' ladder.)
5. All exterior electrical, plumbing, mechanical or other similar equipment shall be shown on the coordination drawings and shop drawings, and shall be easily accessed without disturbing or traversing any landscaping.
- B. Product Data: Product data includes the manufacturer's printed literature, and the complete model number for each piece of equipment.
- C. Performance Data: Provide performance data, wiring and control diagrams.
- D. Installation Instructions: Installation instructions include detailed information, from the manufacturer, indicating specific installation requirements, instructions, and recommendations. Generic installation instructions are not acceptable. Instructions shall be the same as those included with the product when it is shipped from the factory.
- E. Written Operating Instructions: Operating instructions shall be the manufacturer's written operating instructions for the specified product. If the instructions cover more than one model or type of product they shall be clearly marked to identify the instructions that cover the product delivered to the project.
- F. Maintenance Instructions: Maintenance instructions shall be the manufacturer's printed instructions and parts lists for the equipment furnished. If the instructions cover more than one model or type of equipment they shall be marked to identify the instructions for the furnished product.
- G. Operations and Maintenance Manuals:
1. In addition to the comments noted above refer to below CxA requirements and refer to Commissioning Specifications and Commissioning Plan for additional requirements.
  2. O&Ms shall be submitted (30) days after the approved equipment submittals.
  3. O&M data shall be developed and compiled in accordance with ASHRAE Guideline 4.
  4. One (1) bound copy and two (2) copies in PDF format are required. The PDF shall include recognizable text and bookmarks for ease of navigation.
  5. The equipment submittals shall be provided by the CM in (1) complete and cohesive PDF package. If PDFs are combined, each submittal section shall be individually bookmarked to aid in navigation and review.
  6. Any documentation that requires project completion shall be provided with a detailed placeholder indicating the information needed and the anticipated date or project milestone. All placeholders shall be filled and incorporated into the O&Ms prior to Substantial Completion.
  7. A Schedule of Fuses, that lists all equipment which uses fuses, shall be included in the O&M manuals. This schedule shall indicate the quantity and size of fuses for each piece of equipment.

8. The following information shall be included in the O&M submittal for each system:
  - a. Manufacturer's installation information
  - b. Manufacturer's operational information
  - c. Manufacturer's maintenance information
  - d. Manufacturer or 3rd party start-up information
  - e. Equipment name and full model number for each piece of equipment that is addressed by the O&M section
  - f. All options or accessories that have been provided are identified and all items that have not been included are stricken
  - g. All requirements to keep warranty in effect
  - h. Any service contracts issued.
9. The O&Ms shall be reviewed and approved by the A/E team.
  - a. When the A/E team's approval of the O&Ms is imminent, the CxA shall be notified proceed with a commissioning process related review of the documents. The CxA's comments shall be returned to the A/E team. The A/E team shall respond to these comments (where required response is needed by the A/E) and incorporate them into their comments to the contractor as needed to provide resolution.

H. Warranty Manuals:

1. In addition to the comments noted above refer to below CxA requirements and refer to Commissioning Specifications and Commissioning Plan for additional requirements.
2. Each manual shall have a "Table of Contents" page and each section shall be easily identified by a tabbed divider sheet.
3. Each manual shall have a title page that includes the name of the project; name of the manual; name, address and telephone number of the Contractor and Sub-contractor; and the date of expiration of the warranty.
4. All warranties are to be begin from the date of Substantial Completion.
5. The warranty manuals shall include a warranty matrix. Below is a list of information that shall be included in the warranty matrix. This information is intended to augment, but not replace any typical warranty requirements.
  - a. This warranty matrix shall be a supplement to other specified warranty document requirements in the project specifications.
  - b. The CM shall prepare and manage a warranty matrix (by division) that includes the warranty information for all of the equipment and systems in the project. The purpose of the warranty matrix is so the owner has a single reference document which provides basic information on warrantees.
  - c. As a minimum, the warranty matrix shall include the following information:

- 1) Product Manufacturer
- 2) Manufacturer Address
- 3) Manufacturer's Project Order Number or Warranty Number
- 4) Serial numbers for all major equipment
- 5) Warranty Department Contact Information (Name, Phone Number, Address)
- 6) Start Date of Warranty
- 7) Duration of Warranty
- 8) Coverage
- 9) Limitation/Exclusions
- 10) Any specific maintenance or documentation requirements to maintain warranty
- 11) Owner of Warranty
- 12) When the A/E team's approval of the Warranty Manual is imminent, the CxA shall be notified proceed with a commissioning process related review of the documents. The CxA's comments shall be returned to the Owner and A/E team. The A/E team shall respond to these comments (where required response is needed by the A/E) and incorporate them into their comments to the contractor as needed to provide resolution.

I. As-Built Documents:

1. In addition to project specification requirements indicated in other specification sections and/or drawing notes, the following requirements shall be incorporated by the contractor.
2. An accurate set of construction as-builts is critical to the sustainability of the building. The following items shall outline the desired process associated with obtaining accurate as-builts:
  - a. As-built documents shall be on the construction site at all times. The documents shall be updated to the current stage of construction, at least weekly.
  - b. A field-copy of the completed as-built drawings shall be available for verification during commissioning verification.
  - c. Following commissioning verification, any modifications shall be completed by the contractor, scanned and provided to the Owner and A/E team in PDF format (and electronic current AutoCAD or Revit format.). The PDF files shall be combined and bookmarked in the same manner as the original construction documents. All PDF bookmarks shall include the drawing number and description from the original titleblock. (Contractor shall provide their own title block for as-builts.)
  - d. The A/E team shall be responsible for using the field-copy of the as-builts, field notes obtained during the construction administration process, and electronic as-builts provided by the contractor, to update the construction documents into an as-built set of documents.

- 1) The as-built drawings and specifications shall be provided to the Owner in an electronic format. This shall include all files and X-refs in DWG or DXF file format, as well as assembled and bookmarked PDFs. There shall be (1) copies provided by way of individual and labeled DVDs.
  - e. The contractor shall be responsible for identifying all in-ground boxes and providing as-built GPS coordinates for these locations on the respective as-built documents.
- J. Training Plan. Refer to Requirements below
- K. Systems Manual. Refer to Requirements below.
- L. Spare Parts:
1. Spare materials shall be provided as a part of this project. In addition to any requirements in the drawings and/or specifications, the following minimum list of items shall be provided:
    - a. 5 of each of temperature sensor
    - b. 1 of each type of humidity sensor
    - c. 1 of each type of CO2 or VOC sensor
    - d. 1 of each type of dry differential pressure sensor and/or switch
    - e. 1 of each type of wet differential pressure sensor and/or switch
    - f. 1 of each type of air flow measuring station
    - g. 1 of each type of CT
    - h. 1 of each type of actuator
    - i. 1 of each type of thermometer
    - j. 1 of each type of pressure gauge
    - k. 1 of each type of BAS controller
    - l. 1 of ANY critical of long lead items
    - m. 2 of each type of BAS controller
    - n. 1 extra of any BAS interface

## 1.8 COORDINATION

- A. Arrange for pipe spaces, chases, slots, and openings in building structure during progress of construction, to allow for HVAC installations.
- B. Coordinate installation of required supporting devices and set sleeves in poured-in-place concrete and other structural components as they are constructed.
- C. Coordinate requirements for access panels and doors for HVAC items requiring access that are concealed behind finished surfaces.
- D. The Contractor shall coordinate efforts of all trades and shall furnish (in writing, with copies to the Architect and Owner) any information necessary to permit the Work of all trades to be installed satisfactorily and with the least possible interference or delay.

- E. The Contractor and all Subcontractors shall prepare a complete set of construction coordination drawings ("Coordination Drawings") indicating the equipment actually purchased and the exact routing and elevations for all lines such as piping, busway, conduit, ductwork, etc., including conduit embedded in concrete and openings, sleeves, etc., required in the structure, walls, partitions, etc. The Coordination Drawings shall be submitted complete for review to the Architect, Engineer and Owner. The Coordination Drawing preparation and completion shall comply with the requirements of the Schedule. Prior to commencing the Work, the Subcontractor shall obtain from the Architect or Engineer a set of AutoCAD compatible format Architectural and Engineering Drawings on compact disks, to be used to produce the Coordination Drawings. The Subcontractor shall give to the Architect and Engineer a written release acceptable to the Architect and Engineer signed by a corporate officer of the Subcontractor, prior to receipt of the compact disks. The sheet metal Drawings, prepared on electronic media (CADD) at a scale not less than 1/4" = 1'-0", shall serve as the base Drawings to which all other Subcontractors will overlay and add their Work. The Division 23 Mechanical Subcontractor shall be designated as the lead contractor in the development of the composite layering process and shall be responsible for electronically restacking the various trade layers into the final composite (CADD) Drawings. Each trade shall draw their Work on separate layers represented by individual colors. Each Coordination Drawing shall be completed and signed off by the other Subcontractors and the Contractor prior to the installation of the Work in the area covered by the specific Coordination Drawing. The Subcontractors Work shall be installed in accordance with the Shop Drawings and the Coordination Drawings and shall include the required maintenance access space and the code clearance space. If the Contractor allows one trade to install their Work before coordinating with the Work of other trades, the Contractor shall make necessary changes to correct the condition without extra cost to the Owner. The Coordination Drawings indicating piping, conduit, busway and equipment support points and loads exceeding 250 lb. imposed on the building structure shall be submitted to the Architect for review and approval. The elevation, location, support points, static, dynamic and expansion forces and loads imposed on the structure at support and anchor points and the size of all lines shall be indicated. All beam penetrations, slab penetrations and sleeves shall be indicated, sized and coordinated with all other Work. All required code clearance space and required maintenance access space shall be indicated and coordinated with all other work. All Work routed underground or embedded in concrete shall be indicated by dimension to column and building lines and shall be coordinated. This requirement for Coordination Drawings shall not be construed as authorization for the Contractor or Subcontractor to make any unauthorized changes to the Drawings. All space allocations shown on the Drawings shall be maintained, such as ceiling height. Prior to final acceptance of the Work, the Contractor shall give the Drawing files in the latest version of AutoCAD or compatible format on CD-RW Recordable Rewrite Compact Discs, containing the Contractor's coordination documentation, to the Owner.

#### 1.9 INSTRUCTION TO THE OWNER

- A. General: Instructions to the Owner shall be accomplished by representatives of the manufacturers involved. Allow time for complete coverage of all operating procedures. Provide field training in the design, operation and maintenance of the equipment and troubleshooting procedures. Explain the identification system, operational diagrams, emergency and alarm provisions, sequencing requirements, seasonal provisions, security,

safety, efficiency and similar provisions of the systems. On the date of substantial completion, turn over the prime responsibility for operation of the mechanical equipment and systems to the Owner's operating personnel.

- B. Training Period: Training period shall encompass a minimum of 12 hours of hands-on instructions with a maximum period of 4 hours per day.
- C. Scheduling: Submit any remaining required items for checking at least one week before final inspection of the work. When submittal items are found acceptable, notify the Owner, in writing, that an "Instruction Conference" may proceed. Conference will be scheduled by the Owner. After the conference, copies of a memo certifying that the "Instruction Conference" and "Completed Demonstration" have been made will be signed by the Owner and the instructors, and one copy will be inserted in each submittal binder.
  - 1. Training shall not be conducted with the owner until after the commissioning activities are complete.
- D. Training Plan Content Requirements:
  - 1. In addition to the comments noted above refer to below CxA requirements and refer to Commissioning Specifications and Commissioning Plan for additional requirements.
  - 2. A Training Plan shall be developed by the contractor and provided to the Owner and A/E team for review and approval prior to any training instruction being conducted. When the A/E team's approval of the Training Plan is imminent, the CxA shall be notified proceed with a commissioning process related review of the documents. The CxA's comments shall be returned to the Owner and A/E team. The A/E team shall respond to these comments (where required response is needed by the A/E) and incorporate them into their comments to the contractor as needed to provide resolution.
  - 3. The information below includes the typical requirements for the training plan for each building system:
    - a. Clearly identify the systems, subsystems, equipment, and assemblies for which training will be required.
      - 1) Outline of instructional topics related to the systems, subsystems, equipment, and assemblies. These topics shall address the design, construction, operation, and maintenance of specific systems, assemblies, and equipment
      - 2) Learning objectives and training delivery methods for each instructional topic
    - b. Clearly identify the number and type of training sessions.

- 1) The training program should be organized into a series of instructional modules, each covering a portion of the facility's systems, equipment, and assemblies.
  - 2) The planned location of the training sessions (classroom, on site, and off site) and the minimum duration of each training session, in hours, to be completed as required in the OPR, Cx Plan, or construction documents
- c. Instructor's qualifications
- d. General purpose of system (design intent).
- 1) Overview and description of the purposes of the system.
- e. Use of project documents.
- 1) Training materials requirements to be employed during the instructional process
  - 2) Training report, records, and recording requirements
  - 3) Upkeep of the Systems Manual and associated maintenance documentation and logs.
- f. Review of control drawings and schematics.
- 1) Review of control drawings and schematics (have copies for attendees)
  - 2) Building automation system (BAS) controls: programming, troubleshooting, alarms, manual operation, interface with integral controls
  - 3) Integral controls (packaged): programming, troubleshooting, alarms, manual operation
- g. Startup, normal operation, shutdown, unoccupied operation, seasonal changeover, manual operation, control setup and programming troubleshooting, and alarms.
- 1) System response to different operating conditions.
  - 2) Startup, loading, normal operation, unloading, shutdown, unoccupied operation, seasonal changeover, etc., as applicable
  - 3) Operation instructions and procedures: the procedures required for normal operation of the facility, including step-by-step instructions for day-to-day operation.
  - 4) Adjustment instructions: information for maintaining operational parameters.
  - 5) System troubleshooting: description of diagnostic step-by-step procedures for determining the source of problems on the system level; review technical service manual in detail.

- 6) Component troubleshooting: description of diagnostic procedures for determining the source of problems on the component level.
  - 7) Common troubleshooting issues and methods, control system warnings and error messages, including using the control system for diagnostics.
  - 8) Troubleshooting procedures: instructions for diagnosing operating problems and procedures for testing and inspecting.
  - 9) Emergency instructions and procedures: those required for operating the facility during various emergencies, including step-by-step instructions for each type of emergency.
- h. Interactions with other systems, including operation during power outage and fire.
  - i. Adjustments and optimizing methods for energy conservation.
  - j. Relevant health and safety issues and concerns and special safety features.
  - k. Demonstrate for the Owner that all floors with floor drains are pitched to the floor drain. Demonstrate all floor drains during training.
  - l. As a part of training, the contractor shall arrange for the Owner to access each piece of equipment located above finished floor, to confirm that clear vertical spaces have been provided.
  - m. All equipment located above the ceiling or behind an access door shall have the name of the equipment provided on the ceiling grid or access door that is clearly visible from ground level. This includes, but is not limited to air terminal units, valves, fire dampers and exhaust fans. During training the contractor shall identify each of these labels during a walk-thru style review with the Owner.
  - n. Component maintenance:
    - 1) Instruction of required procedures for weekly, monthly, and annual preventive checks and timely repairs to preserve system integrity (sources, spare parts inventory, special tools, etc.).
    - 2) Any special issues to maintain warranty.
    - 3) Repair procedures: instructions for diagnosing problems and for disassembly, component removal, replacement, and reassembly.
  - o. The anticipated capabilities and knowledge of the occupants and operations and maintenance personnel.
    - 1) Measurable learning objectives and teaching outlines should be developed to clearly describe the specific skills and knowledge that the participant is expected to master.
  - p. Occupant interaction issues.
    - 1) Special requirements of tenants for this equipment's function.
  - q. Question and Answer Period.

4. Supplemental requirements for the Training have been provided below. These supplemental requirements shall be integrated with the training plan requirements as applicable.
  - a. A digital video recording of each training session shall be made and three (3) copies shall be provided to the Owner prior to Substantial Completion.
  - b. A minimum of four (4) hours of instruction shall be provided for each system or major piece of equipment.
  - c. Classroom training shall be provided for the BAS system in the following quantities; three (3) day basic operator training for four (4) students; four (4) day intermediate training for four (4) students; four (4) day advance training for four (4) students.
  - d. One week of factory training for two (2) operators at the general level and one week for two (2) operators at the advanced level shall be provided for the BAS system.
  - e. Owner personnel shall receive training in the prevention, recognition and resolution of indoor environmental quality concerns.
  - f. The Owner requires at least two (2) weeks reviewing the contractor provided training schedule and responding with availability for training sessions.
  - g. The Owner desires more hands on training. Contractor shall indicate hands on sessions vs classroom sessions in the training plan for review by the Owner.
  - h. Multiple sessions and shifts shall be coordinated with the Owner.
  - i. Multi-lingual training shall be coordinated with the Owner for specific personnel and systems.
  - j. All training shall include Standard Operating Procedures and the Procedures indicated above

E. Systems Manual:

1. A Systems Manual shall be developed for the commissioned systems. This document shall be developed to comply with the requirements and recommendations of ASHRAE 202-2013, ASHRAE GL-0-2005, ASHRAE GL-4 and LEED 2009. Refer to the table indicated in the Commissioning specifications, for the general format of the document and the responsible parties.
2. The initial system manual shall be submitted (30) days after the approved equipment.
3. The Final System manual shall be submitted prior to commissioning verification and substantial completion, whichever is first.
4. At the time of the initial and final system manual submission, the CxA shall provide the section covers and table of contents documents as described in the Commissioning plan. The documents will then be sent to the Design (A/E) Team for review and comment. Following approval; the A/E team, Owner, Contractor shall incorporate their portions of the systems manual and the forward it the CxA for verification. The CxA will return any comments to the A/E team and incorporate their portions of the systems manual.

## PART 2 - PRODUCTS

### 2.1 MANUFACTURERS

- A. Specified Products: Manufacturer's names and product model numbers indicated on the drawings and in these specifications establish the type, style, quality, performance, and sound rating of the desired product. Listing of other manufacturers indicates that their equivalent products would be acceptable if they meet the specification requirements, the specific use and installation shown on the drawings, including space and clearance requirements, and the energy consumption and efficiency of the specified product.
- B. Space Requirements: All manufactured products furnished on this project must have the required space and service areas indicated in the manufacturer's printed literature or shown on their approved shop drawings. When the manufacturer does not indicate the space required for servicing the equipment, the space shown on the drawings or as required by the Engineer must be provided.

### 2.2 MATERIAL AND EQUIPMENT

- A. General: Material and equipment used shall be produced by manufacturers regularly engaged in the production of similar items, and with a history of satisfactory use as judged by the Engineer.
- B. Specified Equipment: Equipment shall be the capacity and types indicated. Equipment and material furnished shall be the manufacturer's standard item of production unless specified or required to be modified to suit job conditions. Sizes, material, finish, dimensions and the capacities for the specified application shall be published in catalogs for national distribution. Ratings and capacities shall be certified by a recognized rating bureau. Products shall be complete with accessories, trim, finish, safety guards and other devices and details needed for a complete installation and for the intended use and effect.
- C. **Compatibility:** Material and equipment of one and the same kind, type or classification and used for identical or similar purposes shall be made by the same manufacturer. Where more than one choice is available, select the options which are compatible with other products already selected. Compatibility is a basic general requirement of product selection.
- D. Zero where possible, and Low VOC construction materials shall be utilized for this project to comply with owners OPR and BOD. Product submittals shall clearly indicate compliance with this project requirement.

### 2.3 PIPE, TUBE, AND FITTINGS

- A. Refer to individual Division 23 piping Sections for pipe, tube, and fitting materials and joining methods.
- B. Pipe Threads: ASME B1.20.1 for factory-threaded pipe and pipe fittings.

## 2.4 JOINING MATERIALS

- A. Refer to individual Division 23 piping Sections for special joining materials not listed below.
- B. Pipe-Flange Gasket Materials: Suitable for chemical and thermal conditions of piping system contents.
  - 1. ASME B16.21, nonmetallic, flat, asbestos-free, 1/8-inch maximum thickness unless thickness or specific material is indicated.
    - a. Full-Face Type: For flat-face, Class 125, cast-iron and cast-bronze flanges.
    - b. Narrow-Face Type: For raised-face, Class 250, cast-iron and steel flanges.
  - 2. AWWA C110, rubber, flat face, 1/8 inch thick, unless otherwise indicated; and full-face or ring type, unless otherwise indicated.
- C. Flange Bolts and Nuts: ASME B18.2.1, carbon steel, unless otherwise indicated.
- D. Solder Filler Metals: ASTM B 32, lead-free alloys. Include water-flushable flux according to ASTM B 813.
- E. Brazing Filler Metals: AWS A5.8, BCuP Series, copper-phosphorus alloys for general-duty brazing, unless otherwise indicated; and AWS A5.8, BAg1, silver alloy for refrigerant piping, unless otherwise indicated.
- F. Welding Filler Metals: Comply with AWS D10.12 for welding materials appropriate for wall thickness and chemical analysis of steel pipe being welded.

## 2.5 DIELECTRIC FITTINGS

- A. Description: Combination fitting of copper alloy and ferrous materials with threaded, solderjoint, plain, or weld-neck end connections that match piping system materials.
- B. Insulating Material: Suitable for system fluid, pressure, and temperature.
- C. Dielectric Unions: Factory-fabricated, union assembly, for 250-psig minimum working pressure at 180 deg F.
- D. Dielectric Flanges: Factory-fabricated, companion-flange assembly, for 150- or 300-psig minimum working pressure as required to suit system pressures.
- E. Dielectric Couplings: Galvanized-steel coupling with inert and noncorrosive, thermoplastic lining; threaded ends; and 300-psig minimum working pressure at 225 deg F.
- F. Dielectric Nipples: Electroplated steel nipple with inert and noncorrosive, thermoplastic lining; plain, threaded, or grooved ends; and 300-psig minimum working pressure at 225 deg F .

## 2.6 MECHANICAL SLEEVE SEALS

- A. Description: Modular sealing element unit, designed for field assembly, to fill annular space between pipe and sleeve.
  - 1. Sealing Elements: EPDM interlocking links shaped to fit surface of pipe. Include type and number required for pipe material and size of pipe.
  - 2. Pressure Plates: Stainless steel. Include two for each sealing element.
  - 3. Connecting Bolts and Nuts: Stainless steel of length required to secure pressure plates to sealing elements. Include one for each sealing element.

## 2.7 SLEEVES

- A. Galvanized-Steel Sheet: 0.0239-inch minimum thickness; round tube closed with welded longitudinal joint.
- B. Steel Pipe: ASTM A 53, Type E, Grade B, Schedule 40, galvanized, plain ends.
- C. Cast Iron: Cast or fabricated "wall pipe" equivalent to ductile-iron pressure pipe, with plain ends and integral waterstop, unless otherwise indicated.
- D. Stack Sleeve Fittings: Manufactured, cast-iron sleeve with integral clamping flange. Include clamping ring and bolts and nuts for membrane flashing.
  - 1. Underdeck Clamp: Clamping ring with set screws.
- E. Molded PVC: Permanent, with nailing flange for attaching to wooden forms.
- F. PVC Pipe: ASTM D 1785, Schedule 40.

## 2.8 ESCUTCHEONS

- A. Description: Manufactured wall and ceiling escutcheons and floor plates, with an ID to closely fit around pipe, tube, and insulation of insulated piping and an OD that completely covers opening.
- B. One-Piece, Deep-Pattern Type: Deep-drawn, box-shaped brass with polished chrome-plated finish.
- C. One-Piece, Cast-Brass Type: With set screw.
  - 1. Finish: Polished chrome-plated.
- D. One-Piece, Stamped-Steel Type: With set screw or spring clips and chrome-plated finish.
- E. Split-Plate, Stamped-Steel Type: With exposed-rivet hinge, set screw or spring clips, and chrome-plated finish.
- F. One-Piece, Floor-Plate Type: Cast-iron floor plate.

## 2.9 VIBRATION AND SOUND CONTROL

- A. Sound is of the utmost critical nature in this facility. The contractor shall comply with Specification Section 230548 Vibration Controls for HVAC Piping & Equipment. Contractor shall provide isolation and support in strict accordance to the specification.
  - 1. Contractor shall provide all necessary vibration isolation and support to install a noise and vibration-free systems.
- B. Contractor shall provide hanging and support in compliance with Specification Section 23 0529 Hangers and Supports for HVAC Piping and Equipment.

## 2.10 EXPOSED DUCTWORK AND EQUIPMENT

- A. All exposed ductwork and equipment shall be installed with attention to aesthetic details. System shall be installed in a logical method.
  - 1. Equipment shall be systematically laid out. Exposed piping, ductwork, etc. that is visually undesirable to the architect/engineer shall be reinstalled at the contractor's sole expense.
  - 2. Exposed Ductwork in the space that is visually undesirable to the architect/engineer shall be reinstalled at the contractor's sole expense.

## 2.11 EQUIPMENT GREASE FITTINGS

- A. Provide grease fittings for all equipment requiring grease for maintenance. Grease fittings shall fit a standard grease gun.
- B. Access to grease points on all equipment shall be provided without the use of remote grease fittings. If this cannot be provided, the remote grease lines shall be copper, with grease fittings located in an accessible location.

## PART 3 - EXECUTION

### 3.1 WORKMANSHIP

- A. General: Personnel who install materials and equipment shall be qualified by training and experience to perform their assigned tasks.
- B. Performance: Material and equipment installations not in compliance with the Contract Documents, or installed with substandard workmanship in the opinion of the Engineer, shall be removed and reinstalled.

### 3.2 CLEANING AND PROTECTION

- A. General: Refer to Division 01.

- B. Housekeeping: Keep interiors of duct and pipe systems clean and free from dirt, rubbish and foreign matter. Close open ends of piping and ductwork at all times throughout the installation. Install 30% efficient filter media over each return air grille and open return duct opening; change media regularly during construction when dirty to keep duct interiors clean. Prevent dust, debris and foreign material from entering the piping and ductwork.
- C. Equipment Protection: Protect fan motors, switches, equipment, fixtures, and other items from dirt, rubbish and foreign matter. Do not operate air handling equipment if the building is not clean or if dust can enter the coils or the fan housings.
- D. Equipment Cleaning: Thoroughly clean equipment and entire piping systems internally upon completion of installation and immediately prior to Submittal Completion. Open dirt pockets and strainers, blow down each piping system and clean strainer screens of accumulated debris. Remove accumulated dirt, scale, oil and foreign substances. Thoroughly wipe clean internal surfaces of ductwork and air handling units prior substantial completion. ~~Refer to Section 15060, Pipe and Fittings, for detailed requirements for piping systems' flushing and cleaning.~~
- E. Fixture Cleanup: Remove temporary labels, stickers, etc., from fixtures and equipment. Do not remove permanent name plates, equipment model numbers, ratings, etc.
- F. Filter Replacement: Provide filters, with the same efficiency rating as required for the final installation, for the protection of the air moving equipment and ductwork continuously throughout the construction phase. Provide a new set of clean filters for the test and balance of the air side equipment.
- G. Protection of Finished Installation: Where installation is required in areas previously finished by other trades, protect the area from marring, soiling or other damage.

### 3.3 CORRECTION OF WORK

- A. General: At no additional cost to the Owner, rectify discrepancies between the actual installation and Contract Documents when in the opinion of the Testing and Balancing Agency (T&B Agency) or the Engineer the discrepancies will affect system balance and performance.
- B. Drive Changes: Include the cost of all pulley, belt, and drive changes, as well as balancing dampers, valves and fittings, and access panels to achieve proper system balance recommended by the T&B Agency.

### 3.4 COORDINATION AND ASSISTANCE

- A. General: Provide all labor, equipment, tools and material required to operate the equipment and systems necessary for the testing and balancing of the systems and for the adjustment, calibration and repair of all electric or pneumatic automated control devices and components. These services shall be available on each working day during the period of final testing and balancing.

- B. Drawings and Specifications: Provide to the T&B Agency a complete set of project record drawings and specifications and an approved copy of all HVAC shop drawings and equipment submittals. The T&B Agency shall be informed of all changes made to the system during construction, including applicable change orders.
- C. Coordination: Coordinate the work of all trades and equipment suppliers to complete the modifications recommended by the T&B Agency and accepted by the Engineer. Cut or drill holes for the insertion of air measuring devices as directed for test purposes; repair to as-new condition, inserting plastic caps or covers to prevent air leakage. Repair or replace insulation and re-establish the integrity of the vapor retardant.

### 3.5 PIPING SYSTEMS - COMMON REQUIREMENTS

- A. Install piping according to the following requirements and Division 23 Sections specifying piping systems.
- B. Drawing plans, schematics, and diagrams indicate general location and arrangement of piping systems. Indicated locations and arrangements were used to size pipe and calculate friction loss, expansion, pump sizing, and other design considerations. Install piping as indicated unless deviations to layout are approved on Coordination Drawings.
- C. Install piping in concealed locations, unless otherwise indicated and except in equipment rooms and service areas.
- D. Install piping indicated to be exposed and piping in equipment rooms and service areas at right angles or parallel to building walls. Diagonal runs are prohibited unless specifically indicated otherwise.
- E. Install piping above accessible ceilings to allow sufficient space for ceiling panel removal.
- F. Install piping to permit valve servicing.
- G. Install piping at indicated slopes.
- H. Install piping free of sags and bends.
- I. Install fittings for changes in direction and branch connections.
- J. Install piping to allow application of insulation.
- K. Select system components with pressure rating equal to or greater than system operating pressure.
- L. Install escutcheons for penetrations of walls, ceilings, and floors according to the following:
  - 1. Piping:

- a. Piping with Fitting or Sleeve Protruding from Wall: One-piece, deep-pattern type.
- b. Insulated Piping: One-piece, stamped-steel type with spring clips.
- c. Bare Piping at Wall and Floor Penetrations in Finished Spaces: One-piece, castbrass type with polished chrome-plated finish.
- d. Bare Piping at Wall and Floor Penetrations in Finished Spaces: One-piece, stamped-steel type.
- e. Bare Piping at Ceiling Penetrations in Finished Spaces: One-piece or split-casting, cast-brass type with polished chrome-plated finish.
- f. Bare Piping at Ceiling Penetrations in Finished Spaces: One-piece, stamped-steel type or split-plate, stamped-steel type with concealed hinge and set screw.
- g. Bare Piping in Unfinished Service Spaces: One-piece, cast-brass type with polished chrome-plated finish.
- h. Bare Piping in Unfinished Service Spaces: One-piece, stamped-steel type with concealed or exposed-rivet hinge and set screw or spring clips.
- i. Bare Piping in Equipment Rooms: One-piece, cast-brass type.
- j. Bare Piping in Equipment Rooms: One-piece, stamped-steel type with set screw or spring clips.
- k. Bare Piping at Floor Penetrations in Equipment Rooms: One-piece, floor-plate type.

### 3.6 PIPING JOINT CONSTRUCTION

- A. Join pipe and fittings according to the following requirements and Division 23 Sections specifying piping systems.
- B. Ream ends of pipes and tubes and remove burrs. Bevel plain ends of steel pipe.
- C. Remove scale, slag, dirt, and debris from inside and outside of pipe and fittings before assembly.
- D. Soldered Joints: Apply ASTM B 813, water-flushable flux, unless otherwise indicated, to tube end. Construct joints according to ASTM B 828 or CDA's "Copper Tube Handbook," using leadfree solder alloy complying with ASTM B 32.
- E. Brazed Joints: Construct joints according to AWS's "Brazing Handbook," "Pipe and Tube" Chapter, using copper-phosphorus brazing filler metal complying with AWS A5.8.
- F. Threaded Joints: Thread pipe with tapered pipe threads according to ASME B1.20.1. Cut threads full and clean using sharp dies. Ream threaded pipe ends to remove burrs and restore full ID. Join pipe fittings and valves as follows:
  1. Apply appropriate tape or thread compound to external pipe threads unless dry seal threading is specified.
  2. Damaged Threads: Do not use pipe or pipe fittings with threads that are corroded or damaged. Do not use pipe sections that have cracked or open welds.

- G. Welded Joints: Construct joints according to AWS D10.12, using qualified processes and welding operators according to Part 1 "Quality Assurance" Article.
- H. Flanged Joints: Select appropriate gasket material, size, type, and thickness for service application. Install gasket concentrically positioned. Use suitable lubricants on bolt threads.

### 3.7 PIPING CONNECTIONS

- A. Make connections according to the following, unless otherwise indicated:
  - 1. Install unions, in piping NPS 2 and smaller, adjacent to each valve and at final connection to each piece of equipment.
  - 2. Install flanges, in piping NPS 2-1/2 and larger, adjacent to flanged valves and at final connection to each piece of equipment.
  - 3. Wet Piping Systems: Install dielectric coupling and nipple fittings to connect piping materials of dissimilar metals.

### 3.8 EQUIPMENT INSTALLATION - COMMON REQUIREMENTS

- A. Install equipment to allow maximum possible headroom unless specific mounting heights are not indicated.
- B. Install equipment level and plumb, parallel and perpendicular to other building systems and components in exposed interior spaces, unless otherwise indicated.
- C. Install HVAC equipment to facilitate service, maintenance, and repair or replacement of components. Connect equipment for ease of disconnecting, with minimum interference to other installations. Extend grease fittings to accessible locations.
- D. Install equipment to allow right of way for piping installed at required slope.

### 3.9 PAINTING

- A. Painting of HVAC systems, equipment, and components is specified in Division 9 Sections "Interior Painting" and "Exterior Painting."
- B. Damage and Touchup: Repair marred and damaged factory-painted finishes with materials and procedures to match original factory finish.

### 3.10 CONCRETE BASES

- A. Concrete Bases: Anchor equipment to concrete base according to equipment manufacturer's written instructions and according to seismic codes at Project.
  - 1. Construct concrete bases of dimensions indicated, but not less than 4 inches larger in both directions than supported unit.

2. Install dowel rods to connect concrete base to concrete floor. Unless otherwise indicated, install dowel rods on 18-inch centers around the full perimeter of the base.
3. Install epoxy-coated anchor bolts for supported equipment that extend through concrete base, and anchor into structural concrete floor.
4. Place and secure anchorage devices. Use supported equipment manufacturer's setting drawings, templates, diagrams, instructions, and directions furnished with items to be embedded.
5. Install anchor bolts to elevations required for proper attachment to supported equipment.
6. Install anchor bolts according to anchor-bolt manufacturer's written instructions.
7. Use minimum 3000-psi (or higher psi rating if required by the equipment manufacture or structural drawings), 28-day compressive-strength concrete and reinforcement as specified in Division 3 Section "Cast-in-Place Concrete."

### 3.11 ERECTION OF METAL SUPPORTS AND ANCHORAGES

- A. Refer to Division 5 Section "Metal Fabrications" for structural steel.
- B. Cut, fit, and place miscellaneous metal supports accurately in location, alignment, and elevation to support and anchor HVAC materials and equipment.
- C. Field Welding: Comply with AWS D1.1.

### 3.12 GROUTING

- A. Mix and install grout for HVAC equipment base bearing surfaces, pump and other equipment base plates, and anchors.
- B. Clean surfaces that will come into contact with grout.
- C. Provide forms as required for placement of grout.
- D. Avoid air entrapment during placement of grout.
- E. Place grout, completely filling equipment bases.
- F. Place grout on concrete bases and provide smooth bearing surface for equipment.
- G. Place grout around anchors.
- H. Cure placed grout.

### 3.13 ACCESS DOORS AND FRAMES

- A. Provide access doors and frames of the appropriate size and locations to allow access to mechanical equipment, valves, dampers, etc. All locations are to be field verified with the Architect prior to installation.

3.14 CEILING GRID / ACCESS DOOR LABELING AND EQUIPMENT LABELS:

- A. All equipment located above the ceiling or behind an access door shall have the name of the equipment provided on the ceiling grid or access door that is clearly visible from ground level. This includes, but is not limited to air terminal units, valves, fire dampers and exhaust fans. During training the contractor shall identify each of these labels during a walk-thru style review with the Owner.
- B. Equipment shall be clearly labeled (including but not limited to starters, disconnects, VFDs, Equipment...) and shall be consistent with the names used on the design drawings.
- C. Refer to individual specification sections for additional labeling requirements.
- D. Refer to Specification Section 230553 "Identification for HVAC Piping and Equipment" for additional requirements.

3.15 IN GROUND BOXES:

- A. All in-ground electrical boxes, valve boxes or other similar equipment smaller than 24"x24" shall have a concrete pad poured around the perimeter to extend the edges of the location to at least 24"x24".

3.16 INSTALLATION OF HVAC EQUIPMENT SUPPLIED BY OTHERS DIVISIONS

- A. A. Division 23 Contractors shall be responsible provide all necessary labor, materials, and coordination required for successful installation of equipment provide by other divisions but vital for successful operation of HVAC equipment. Equipment and materials vital for successful operation of HVAC equipment include but are not limited to the follow:
  - 1. Control Dampers
  - 2. Control Valves
  - 3. Kitchen Equipment:
    - a. Cooler/Freezer Refrigeration Equipment
    - b. Cooler/Freezer Refrigerant Piping
    - c. Cooler/Freezer Refrigeration Curbing/Support/Wind Restraints
  - 4. Thermowells
  - 5. Pipe Taps
  - 6. Water Sensors and Switches

3.17 PREPARATIONS FOR PERFORMANCE VERIFICATION

- A. See Specification Section 230593 TESTING, ADJUSTING, AND BALANCING
- B. Verification: Prior to commencement of balancing by the T&B Agency, verify the following in writing:

1. Air filters have been replaced and are clean.
2. Linkages between dampers and their actuators are secure, non-overloading and non-binding.
3. Ductwork specialties are in their normal operating positions.
4. Fans are operating at the correct rotation and specified RPM.
5. Ductwork has been pressure tested and accepted.
6. Strainers have been removed, cleaned and replaced, and that temporary construction strainers have been removed.
7. Compression or expansion tanks have been inspected, are not air-bound or water-logged and are pre-charged, and that the piping systems have been completely vented and filled with water.
8. Air vents at coils and high points of the piping systems have been inspected and installed and operating freely.
9. Automatic valves, hand valves, and balancing valves have been placed in a fixed open position for full flow through all devices.
10. Linkages between valves and their actuators are secure, non-overloading and non-binding.
11. Pressures for hydronic reducing valves have been set.
12. Operating temperatures have been set for chillers and regulating valves.
13. Pumps are operating at the correct rotation and specified horsepower.
14. Piping has been pressure tested and accepted and piping systems have been cleaned, flushed, sterilized and refilled with chemicals and prescribed treated water and vented.
15. Operating safety features (such as thermal overloads, firestats, freezestats, smoke detectors and relief valves), are installed and fully functional.
16. Equipment has been lubricated and can be operated without damage.
17. Systems are operational and complete.
18. No latent residual work remains to be completed.

### 3.18 PREFUNCTIONAL AND FUNCTIONAL PERFORMANCE TESTING

- A. Division 23 Contractors shall be responsible to carry out the commissioning requirements specified in the commissioning sections, and all other sections where related to commissioning. Provide all necessary labor, materials, and coordination required for successful completion of the commissioning requirements. Refer to all other individual project specification sections, Commissioning Specifications and Commissioning Plan for additional testing requirements.
- B. System verification: HVAC Controls:
  1. In addition to any other specified System Verification Requirements, the following minimum system verification shall be performed in addition to other project specifications. (Note: If there is a duplicate of system verification, it is not the intent to specify System Verification twice, but to establish the minimum requirements if not specified otherwise.)
  2. Verify all sequences of operation, schedules, alarms and notifications

- a. Test method:
    - 1) Sequences, alarms and notifications will be demonstrated by the controls contractor using the functional performance test provided by the CxA.
  - b. Requirements to facilitate testing:
    - 1) All sequences of operation, schedules, alarms and notifications shall be included on the contractors shop drawings in accordance with the construction documents, and numbered to allow ease of reference.
    - 2) Each sequence, alarm or notification shall include a defined start, stop and response time value.
3. Verify setpoints and time delays:
- 1) Test method:
    - a) Setpoints and time delays will be demonstrated by the controls contractor using the functional performance test or construction checklists provided by the CxA
  - 2) Requirements to facilitate testing:
  - 3) All setpoints and time delays shall be included on the contractors shop drawings in accordance with the construction documents, along with the following information:
    - a) Values that shall be visible on the user graphics.
    - b) Values adjustable from the user graphics
    - c) Allowable range for user manipulation from the Values being trended
    - d) User adjustments being monitored
    - e) Adjustable range by users in space
4. Verify component calibration:
- a. Component Calibration data required below, shall be clearly indicated in the contractors shop drawings, in accordance with contract drawings and specifications, to facilitate Component Calibration.
  - b. Humidity sensors and temperature sensors (air or water):
    - 1) Test Method:

- a) Calibration will be demonstrated by the TAB and controls contractors using a calibrated test instrument and comparing the control system value to the test measurement obtained within 12" of the sensors location.
- 2) Requirements to facilitate testing: The following values need to be defined in the contractors shop drawings per the contract documents for each sensor type:
  - a) Intended installation location
  - b) Device accuracy defined as a set value, percentage of operating range or percentage of measured value
  - c) Field calibration accuracy defined as a set value, percentage of operating range or percentage of measured value
  - d) Allowable control system or transducer offset
  - e) Wet temperature sensors require a pressure/temperature port that will provide an accurate and consistent reading. Provide a P/T test port by each wet sensor.
  - f) Air sensors require a ductwork location that will provide an accurate and consistent reading, therefore shall be located to provide the specified accuracy in accordance with the manufactures installation guidelines for the actual installation conditions.
- c. Carbon Dioxide (CO2) or Volatile Organic Compound (VOC):
  - 1) Test Method:
    - a) Calibration will be demonstrated by the TAB and controls contractors using an HVAC sequence of operation and test for relative calibration.
    - b) With building empty, allow O/A to enter the building until the reading for the O/A is within 50ppm of the indoor air, then close the O/A damper and continue to circulate indoor air for approximately 1-hr to confirm all sensors measure within 50ppm of each other.
  - 2) Requirements to facilitate testing: The following values need to be defined in the contractors shop drawings per the contract documents for each sensor type:
    - a) Intended installation location
    - b) Device accuracy defined as a set value, percentage of operating range or percentage of measured value
    - c) Field calibration accuracy defined as a set value, percentage of operating range or percentage of measured value

- d) Allowable control system or transducer offset
- d. Airflow measuring stations:
  - 1) Test Method:
    - a) Calibration will be demonstrated by TAB and controls contractor at the top and bottom of the typical operating range by performing a duct traverse up or downstream of device and comparing it to the control system value.
    - b) Where provided on design drawings, verification of an air filter between the unfiltered outside air and the airflow measuring station will be visually verified with the mechanical contractor.
  - 2) Requirements to facilitate testing: The following values need to be defined on the contractors shop drawings in accordance with the contract documents for each sensor:
    - a) Intended installation location on ductwork drawing showing manufacturer recommended upstream and downstream straight duct requirements.
    - b) Intended installation location of the outside air filter.
    - c) Device accuracy defined as a set value, percentage of operating range or percentage of measured value.
    - d) Field calibration accuracy defined as a set value, percentage of operating range or percentage of measured value.
    - e) Allowable control system or transducer offset.
- e. Dampers:
  - 1) Test Method:
    - a) Calibration will be demonstrated by the TAB and controls contractor by conducting a visual verification of the device and comparing it to the control system value.
  - 2) Requirements to facilitate testing:
    - a) Access doors and/or an accessible location within a user serviceable distance from the equipment shall be installed. Doors shall be sized to provide proper service access and accommodate testing/verification.
- f. Hydronic valves:
  - 1) Test Method:

- a) Calibration will be demonstrated by the TAB and controls contractor by conducting a visual verification of the valve stem position and comparing it to the control system value.
  - b) The closed position shall be demonstrated by the TAB contractor using a differential pressure or temperature based leak-by test.
- 2) Requirements to facilitate testing:
- a) Pressure/temperature test ports shall be installed immediately before and after the location of the leak-by test.
- g. Current (Amp) Transducer or Switch:
- 1) Test Method:
    - a) Calibration will be demonstrated by the TAB and controls contractor using a calibrated test instrument and comparing the control system value to the test measurement.
  - 2) Requirements to facilitate testing: The following values need to be defined for each sensor type:
    - a) Intended installation location
    - b) Device accuracy defined as a set value, percentage of operating range or percentage of measured value
    - c) Field calibration accuracy defined as a set value, percentage of operating range or percentage of measured value
    - d) Allowable control system or transducer offset
- h. Hydronic static pressure or differential pressure sensor:
- 1) Test Method:
    - a) Calibration will be demonstrated by the TAB and controls contractor at the top and bottom of the typical operating range using a calibrated test instrument and comparing it to the control system value.
  - 2) Requirements to facilitate testing: The following values need to be defined for each sensor type:
    - a) Intended installation location
    - b) Device accuracy defined as a set value, percentage of operating range or percentage of measured value.
    - c) Field calibration accuracy defined as a set value, percentage of operating range or percentage of measured value
    - d) Allowable control system or transducer offset.

- e) Wet pressure sensors require a pressure/temperature port that will provide an accurate and consistent reading. Provide a P/T test port tee'd into each wet sensor input to accommodate calibration and testing.
- i. Airflow Switch:
  - 1) Test Method:
    - a) Calibration will be demonstrated by the TAB and controls contractor conducting a visual verification of the device and comparing it to the control system value.
  - 2) Requirements to facilitate testing: The following values need to be defined for each sensor type:
    - a) Intended installation location
    - b) Device accuracy defined as a set value, percentage of operating range or percentage of measured value.
    - c) Field calibration accuracy defined as a set value, percentage of operating range or percentage of measured value.
    - d) Allowable control system or transducer offset.
- j. Hydronic flow meter:
  - 1) Test Method:
    - a) Calibration will be demonstrated by the TAB and controls contractor by isolating flow to a single pump or coil, determining the associated flow based on pressure drop and comparing it to the control system value
  - 2) Requirements to facilitate testing: The following values need to be defined for each sensor type:
    - a) Intended installation location on CHW/HHW piping in accordance with manufacturer recommended upstream and downstream straight piping requirements.
    - b) Device accuracy defined as a set value, percentage of operating range or percentage of measured value.
    - c) Field calibration accuracy defined as a set value, percentage of operating range or percentage of measured value.
    - d) Allowable control system or transducer offset.
- 5. System verification: Each AHU, FCU, RTU or similar air handling device:

- a. Control system components, including but not limited to sequences of operation, setpoints, time delays, dampers and valves shall be verified in accordance with the HVAC Control System information above.
- b. Verify minimum / maximum supply, outside air and exhaust air volume.
  - 1) Test method:
    - a) TAB contractor shall perform a duct traverse and compare it to the design values.
  - 2) Requirements to facilitate testing:
    - a) Identify the intended test location on ductwork shop drawings and any requirement for straight ductwork.
- c. Verify total and external static pressure on equipment
  - 1) Test method:
    - a) TAB contractor shall perform static pressure profile across all associated dampers, filters, coils, heating elements and similar components at the maximum volume and compare it to the design value.
  - 2) Requirements to facilitate testing:
    - a) Adequate access to drill or use pre-installed test ports at each pressure drop location along the equipment. (Contractor shall seal and plug all test ports after testing is complete with a removable plug to accommodate re-testing in the future.).
- d. Verify hydronic volumes:
  - 1) Test method:
    - a) TAB contractor shall demonstrate by measuring wet differential pressure across coil and comparing it to the manufacturer's coil data.
    - b) Verification shall be conducted (and documented) with system at the minimum differential pressure required to satisfy the building's most hydraulically remote device.
  - 2) Requirements to facilitate testing:

- a) Pressure and temperature test ports of adequate length will be needed immediately before and after CHW coil connection. (Install P/T Test ports to accommodate verification.)
- e. Verify static and differential pressure at balancing device.
  - 1) Test method:
    - a) Static and differential pressure will be verified with TAB contractor at the pressure and temperature ports nearest the balancing device.
  - 2) Requirements to facilitate testing:
    - a) Pressure and temperature test ports needed to verify coil GPM should facilitate this test as well.
- f. Verify heat transfer capacity of hydronic heating or cooling coil.
  - 1) Test method:
    - a) While inducing the coil's maximum capacity by manipulating air volumes and temperatures, the TAB contractor will measure the water temperature and pressure drop to calculate the coil capacity.
  - 2) Requirements to facilitate testing:
    - a) Pressure and temperature test ports needed to verify coil GPM should facilitate this test as well.
- g. Verify heat transfer capacity of electric or DX heating or cooling coil:
  - 1) Test method:
    - a) While inducing the coil's maximum capacity by manipulating air volumes and temperatures, temperature before and after the coil will be verified with the TAB contractor and used in conjunction with a known or measured air volume.
    - b) For electric heating coils, capacity may be determined by measuring voltage and amperage in lieu of air temperatures.
  - 2) Requirements to facilitate testing:
    - a) Ductwork test location used for verifying air volumes should also facilitate this test

- h. Verify coil EAT (DB & WB), LAT (DB & WB), EWT and LWT.
  - 1) Test Method:
    - a) These values will be verified with the TAB contractor using a calibrated test instrument upstream and downstream of the coil.
  - 2) Requirements to facilitate testing:
    - a) Sufficient access to ductwork and piping around unit. Testing for the unit's hydronic volumes should facilitate test ports for these measurements as well.
- i. Verify motor(s) HP, amps and volts:
  - 1) Test Method:
    - a) While at maximum design conditions, these values will be verified with the TAB contractor and their previously used calibrated test instruments.
    - b) Requirements to facilitate testing: No specific requirements.
- j. Verify motor and Fan RPM
  - 1) Test Method:
    - a) While at maximum design conditions, these values will be verified the TAB contractors calibrated tachometer.
  - 2) Requirements to facilitate testing: No specific requirements.
- k. Verify VFD operation
  - 1) Test Method:
    - a) All Programmed settings will be accessed locally at the equipment verified with the TAB and mechanical contractor.
    - b) Direction of equipment rotation will be verified with the mechanical contractor using the VFD inverter and the mechanical bypass.
  - 2) Requirements to facilitate testing:
    - a) Programmed settings for the following values need to be defined by the VFD start-up technician and controls contractor for a stable operating system:
      - b) Acceleration & Deceleration time
      - c) Minimum & Maximum operation frequency

- d) Safeties that must remain in place when in bypass
6. System verification: Each Terminal Unit:
- a. Verify control system components including but not limited to sequences of operation, setpoints, time delays, dampers and valves in accordance with the HVAC Control System information above.
  - b. Verify minimum and maximum air volumes for heating and cooling
    - 1) Test Method:
      - a) Air volumes for each grille downstream of the unit shall be verified with the TAB contractor using a duct traverse or flow hood measurement.
    - 2) Requirements to facilitate testing:
      - a) Access to terminal unit and grilles and/or ductwork. (Flow Hood is the preferred method.)
  - c. Verify heat transfer capacity in accordance with the AHU, FCU, RTU information above.
7. System verification: Each Pump:
- a. Verify control system components including but not limited to sequences of operation, setpoints, time delays, dampers and valves in accordance with the HVAC Control System information above.
  - b. Verify volume, head pressure, impeller diameter
  - c. Test Method:
    - 1) Differential pressure across the pump shall be verified with the TAB contractor and compared to the manufacturer's performance curve at shut-off and the systems designed differential pressure setpoint.
    - 2) Requirements to facilitate testing:
      - a) Pressure/temperature ports immediately before and after the pump.
      - b) Differential pressure setpoint used during the TAB. (Note: This should be the lowest differential pressure that maintain the system balance requirements, and is determined during TAB.)
  - d. Verify motor HP, amps, volts, RPM

- 1) Test Method:
    - a) While at maximum design conditions, these values will be verified with the TAB contractor and their previously used calibrated test instruments.
  - 2) Requirements to facilitate testing: No specific requirements
- e. Verify VFDs in accordance with the AHU, FCU, RTU information above.
8. System verification: Each supply fan, exhaust fan or outside air fan:
- a. Verify control system components including but not limited to sequences of operation, setpoints, time delays, dampers and valves in accordance with the HVAC Control System information above.
  - b. Verify minimum / maximum air volume in accordance with the AHU, FCU, RTU information above.
  - c. Verify motor(s) HP, amps and volts in accordance with the AHU, FCU, RTU information above.
  - d. Verify motor and fan RPM in accordance with the AHU, FCU, RTU information above.
  - e. Verify VFDs in accordance with the AHU, FCU, RTU information above.
- C. Photo Documentation of Valves:
1. All automatic flow control balancing valves, manual balancing valves and motorized control valves shall be photographed in their installed position prior to insulation installation. The pictures shall include the nameplate of the associated equipment and the nameplate of the valve with the manufacturer, model, volume and flow direction clearly visible. Additional pictures shall be taken as necessary to clearly illustrate the valves position in the piping relative to the surrounding equipment and devices.
  2. All valves shall be equipped with a valve tag and match the valve chart.
- 3.19 PROTECTION OF MATERIALS AND EQUIPMENT
- A. Requirements: Do not store fiberglass insulation or any equipment within the building until it has been "dried in". If dry space is unavailable and the insulation and equipment must be installed or stored before the building is "dried in" and completely enclosed, provide polyethylene film cover for protection.
  - B. Replacement of Damaged Stored Material and Equipment: Any material and equipment that has been wet or otherwise damaged prior to installation shall be replaced with new material regardless of the condition of the material and equipment at the time of installation.
  - C. Repair of Damaged Installed Material and Equipment: After installation correct or repair dents, scratches and other visible blemishes. At the direction of Engineer replace or repair to "as new" condition equipment which has been damaged during construction.

3.20 COORDINATION OF SERVICES

- A. Interruption of services: Provide shutoff valves at points of interconnection to minimize downtime.

END OF SECTION 23 00 10



C19-2811- AP  
Construction  
of Satellite  
Concourse 'C'



MIGUEL A MARTIN  
FL AR-98279

SEAL

Revisions

No.	Date	Description
2	09-MAR-2020	ADDENDUM 002


Project No.: MLM-19672  
Designed By: MLM, MAM  
Drawn By: ST, CC, DM, CB  
Checked By: MAM  
Issue Date: 21-JAN-2020  
Drawing Scale: 1" = 20'-0"  
Drawing Title:

ARCHITECTURAL  
SITE PLAN

BID DOCUMENTS

Drawing No.:

G201

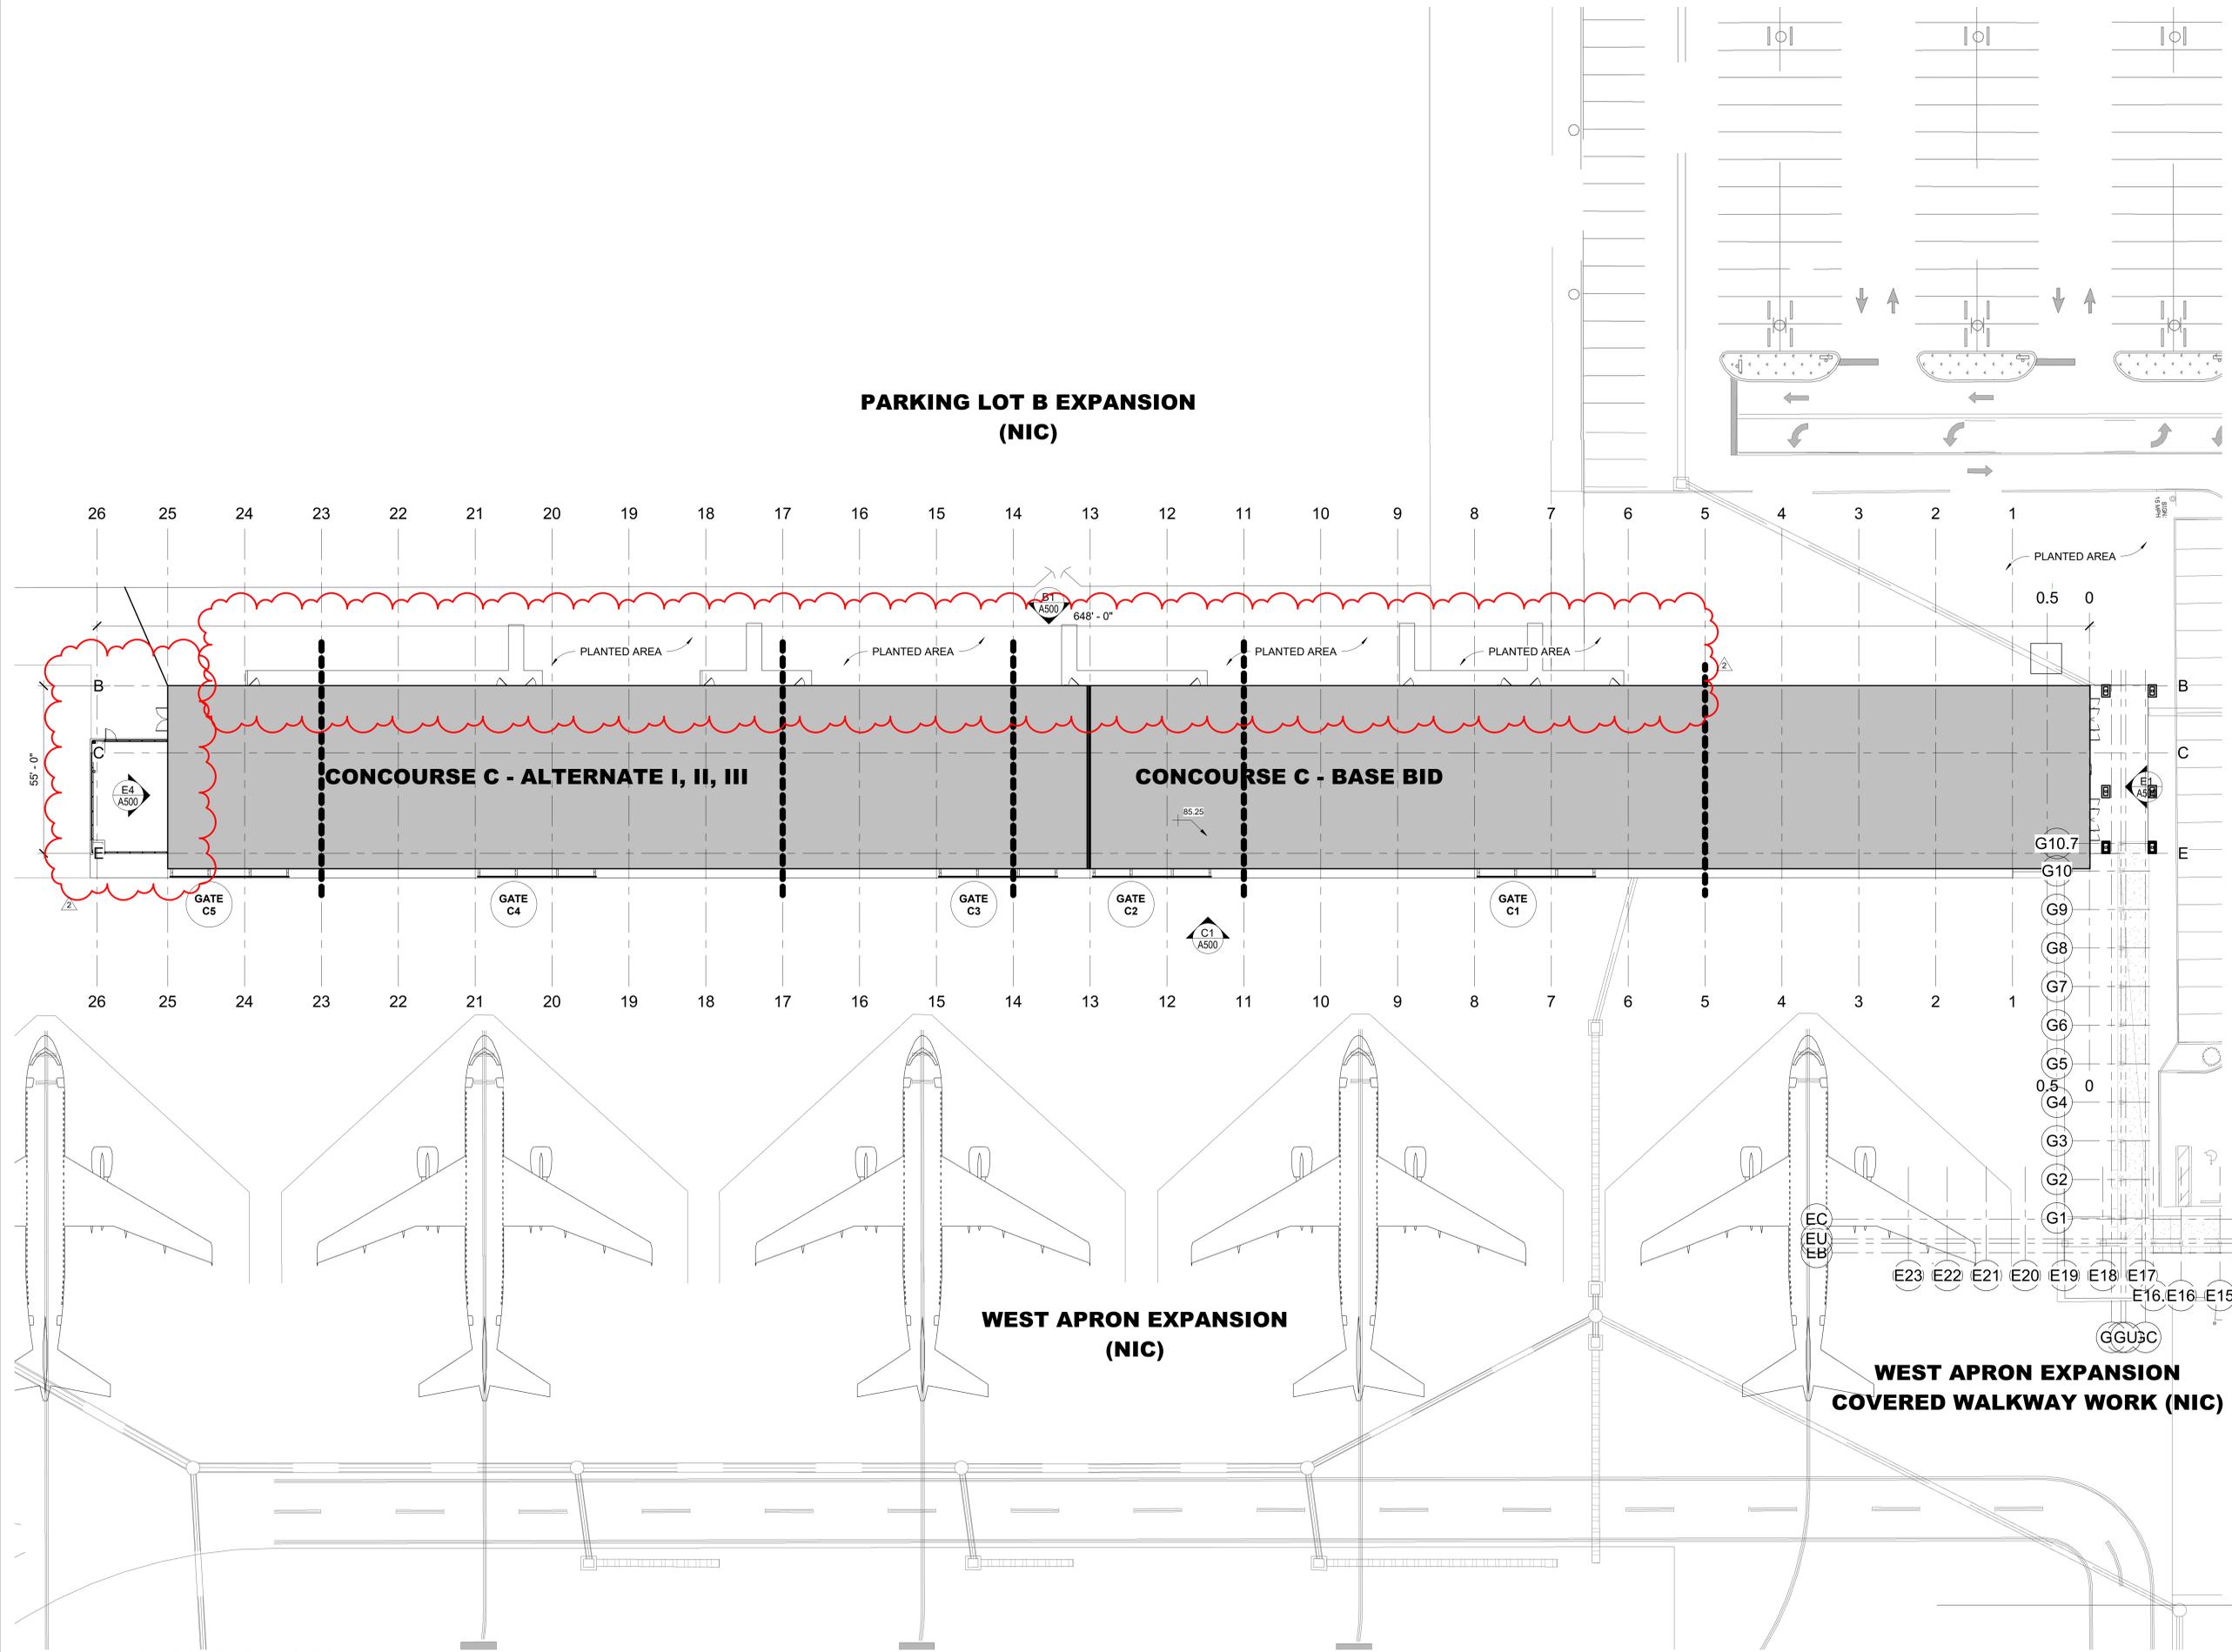

A1 ARCHITECTURAL SITE PLAN  
1" = 20'-0"

BIM 360/Design of Satellite Concourse/VPS-MLM\_A.rvt

3/10/2020 12:21:28 PM



C19-2811- AP  
Construction  
of Satellite  
Concourse 'C'

668 N. ORLANDO AVE  
SUITE 107  
MADLAND, FL 32751  
407.897.6764 (VOICE)  
407.894.1338 (FAX)  
WWW.MLM-MARTIN.COM

MIGUEL A MARTIN  
FL AR-98279

SEAL

Revisions



No.	Date	Description
2	09-MAR-2020	ADDENDUM 002
1	18-FEB-2020	ADDENDUM 001

Project No.: **MLM-19672**  
Designed By: **MLM, MAM**  
Drawn By: **ST, CC, DM, CB**  
Checked By: **MAM**  
Issue Date: **21-JAN-2020**  
Drawing Scale: **1" = 20'-0"**  
Drawing Title:

IDENTIFICATION  
OF  
ALTERNANTES  
BID DOCUMENTS

Drawing No.:

**G211**

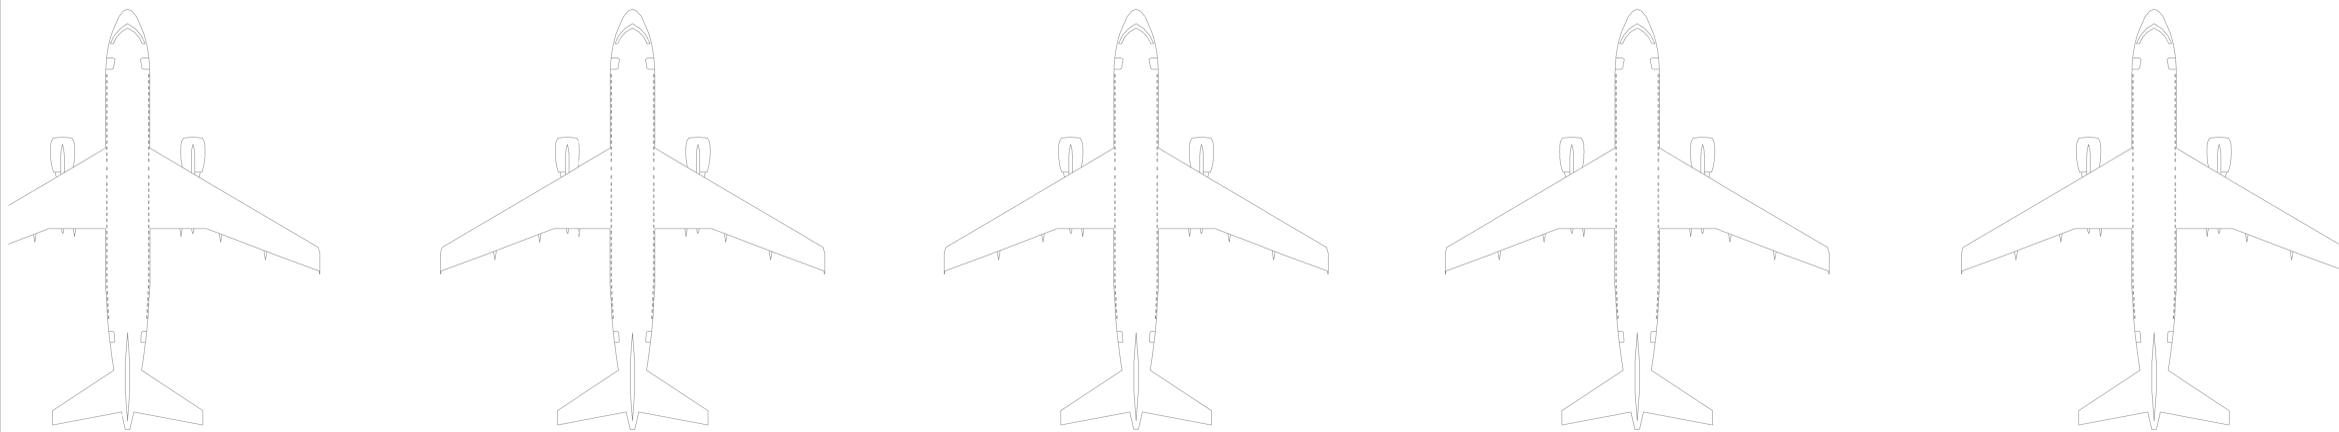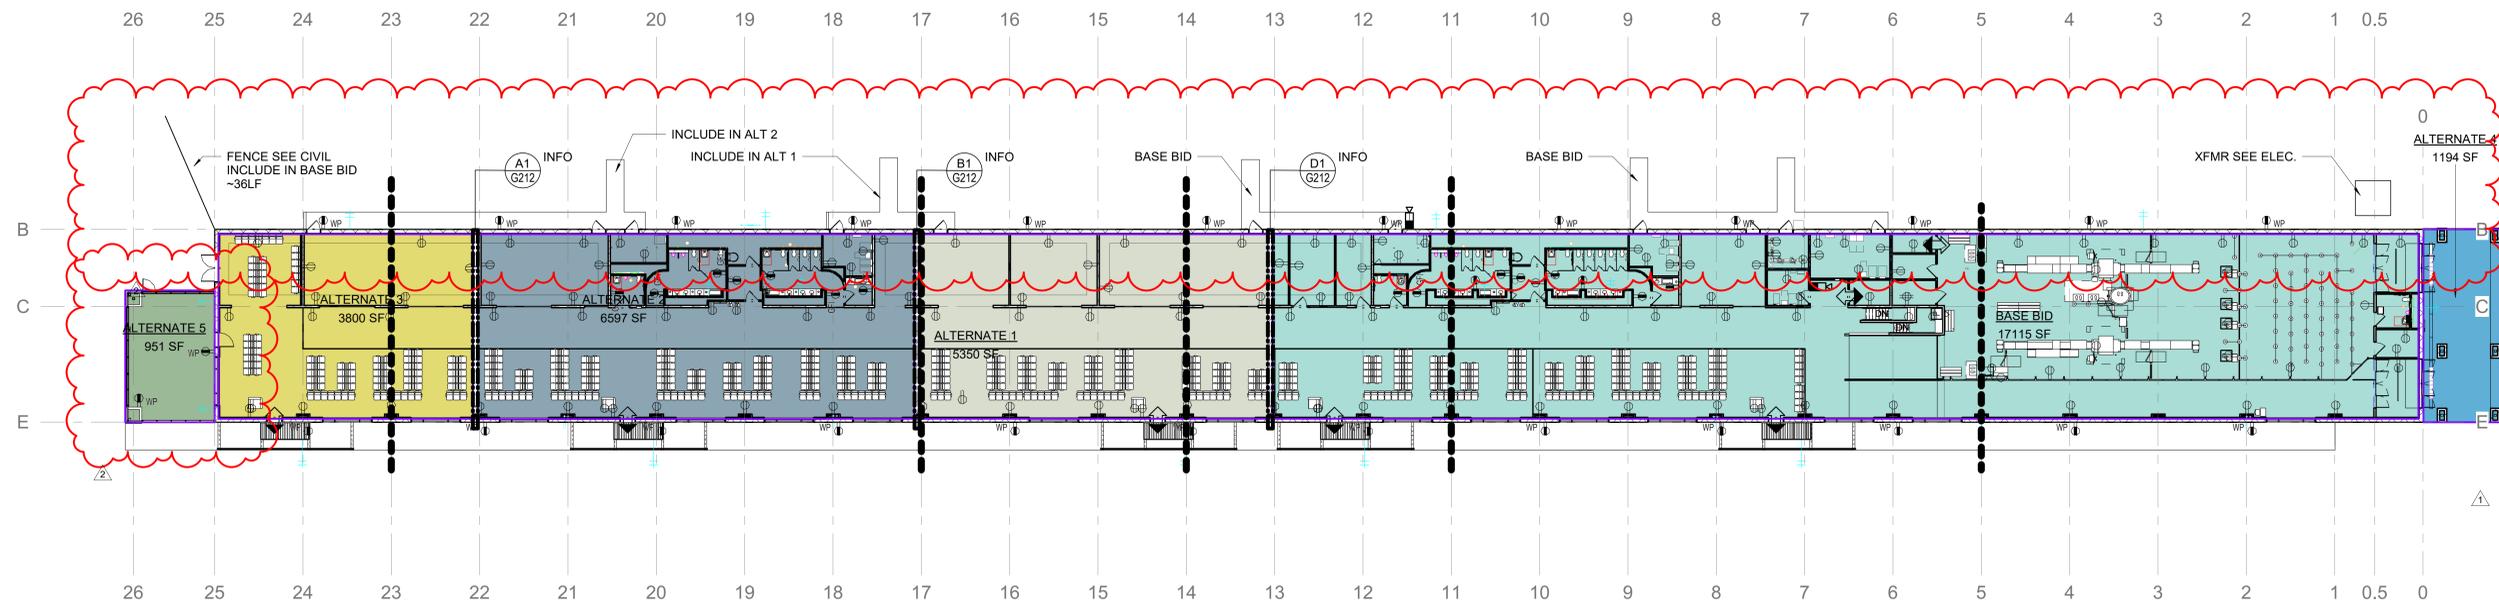

**B1 ALTERNATE IDENTIFICATION PLAN CONCOURSE LEVEL**

1" = 20'-0"




**ALTERNATE LEGEND**


- ALTERNATE 1  
Concessions, Holdrooms C3 :  
REF LINES 13-17
- ALTERNATE 2  
Concessions, Restroom Core 2,  
Holdroom C4: REF LINES 17-22
- ALTERNATE 3  
Holdroom C5: REF LINES 22-25
- ALTERNATE 4  
Covered Entry Canopy and Structure  
Only; Slab in Base Bid
- ALTERNATE 5  
Outdoor Seating Area (Concessions)
- BASE BID  
Entry, TSA Support, SSCP,  
Restroom Core 1, Holdroom C1 & C2:  
REF LINES 00-13

ALTERNATE 6  
SUBSTITUTE "CALLA" HIGH CAC 50  
24" X 24" X 1-3/4" CEILING TILE FOR ACT1  
SEE **AF712**

ALTERNATE 7  
SUBSTITUTE CT2 FOR GT1 AND GT2  
SEE **A45X SERIES & AF712**

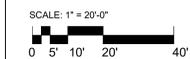

**SHEET PROVIDED FOR  
INFORMATION ONLY**

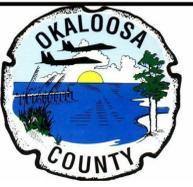

**C19-2811- AP  
Construction  
of Satellite  
Concourse 'C'**



**MIGUEL A MARTIN  
FL AR-98279**

SEAL

**Revisions**

No.	Date	Description
2	09-MAR-2020	ADDENDUM 002

Project No.: **MLM-19672**  
 Designed By: **MLM, MAM**  
 Drawn By: **ST, CC, DM, CB**  
 Checked By: **MAM**  
 Issue Date: **21-JAN-2020**  
 Drawing Scale: **1" = 20'-0"**  
 Drawing Title:

**ILLUSTRATED  
ALTERNATE  
EXECUTION**  
 BID DOCUMENTS

Drawing No.:


**G212**




**D1 ALTERNATE ILLUSTRATION BASE BID + ALTERNATES 4&5**  
 1" = 20'-0"



**B1 ALTERNATE ILLUSTRATION BASE BID + ALTERNATES 1,4&5**  
 1" = 20'-0"

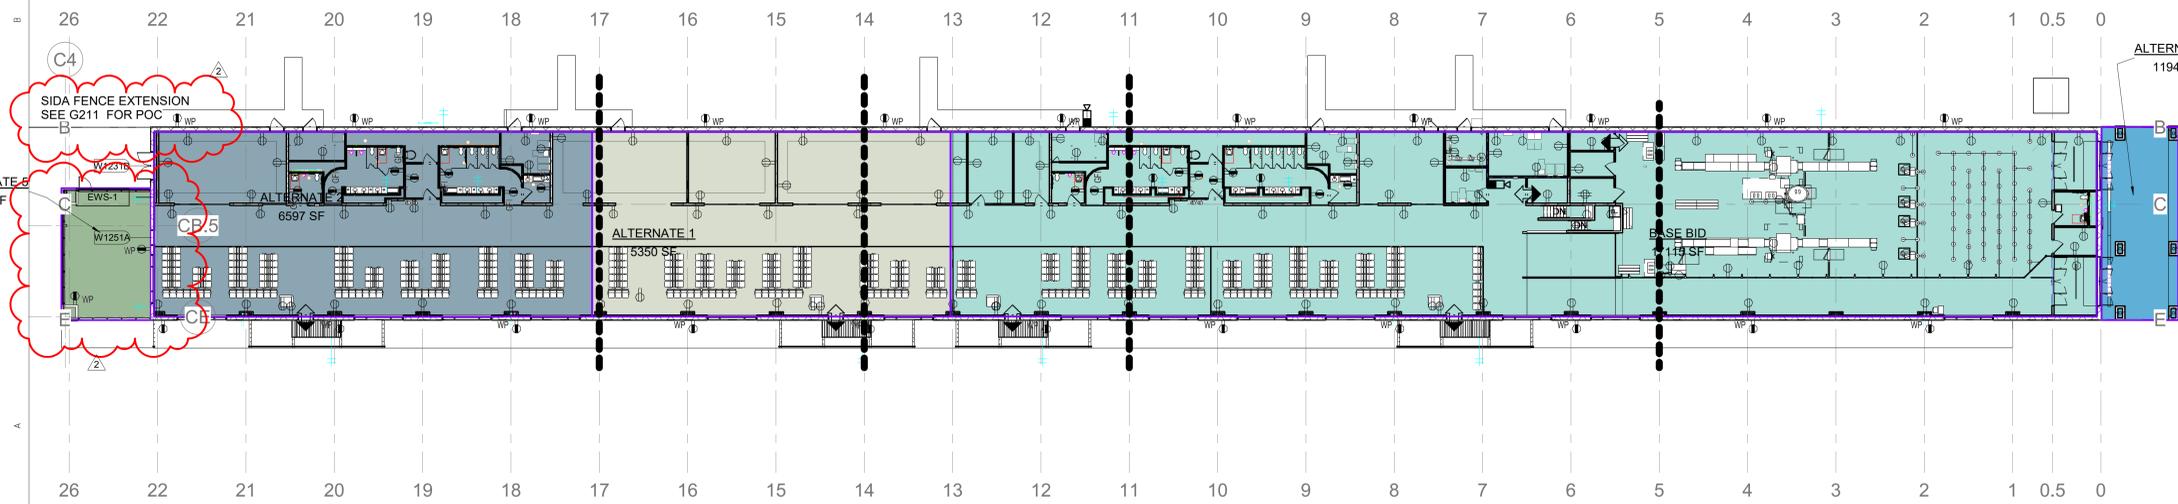

**A1 ALTERNATE ILLUSTRATION BASE BID + ALTERNATES 1,2,4&5**  
 1" = 20'-0"

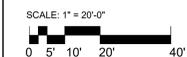

3/10/2020 12:22:24 PM \\Design of Satellite Concourse\VPS-MLM\_A.rvt



C19-2811- AP Construction of Satellite Concourse 'C'

668 N. ORLANDO AVE SUITE 107 MAITLAND, FL 32751 407.897.6764 (VOICE) 407.894.1338 (FAX) WWW.MLM-MARTIN.COM

MIGUEL A MARTIN FL AR-98279

SEAL

Revisions



Table with 3 columns: No., Date, Description. Row 1: 2, 09-MAR-2020, ADDENDUM 002. Row 2: 1, 18-FEB-2020, ADDENDUM 001.

Project No.: MLM-19672
Designed By: MLM, MAM
Drawn By: ST, CC, DM, CB
Checked By: MAM
Issue Date: 21-JAN-2020
Drawing Scale: 1" = 20'-0"

SPACE UTILIZATION PLANS
BID DOCUMENTS

Drawing No.:

G311

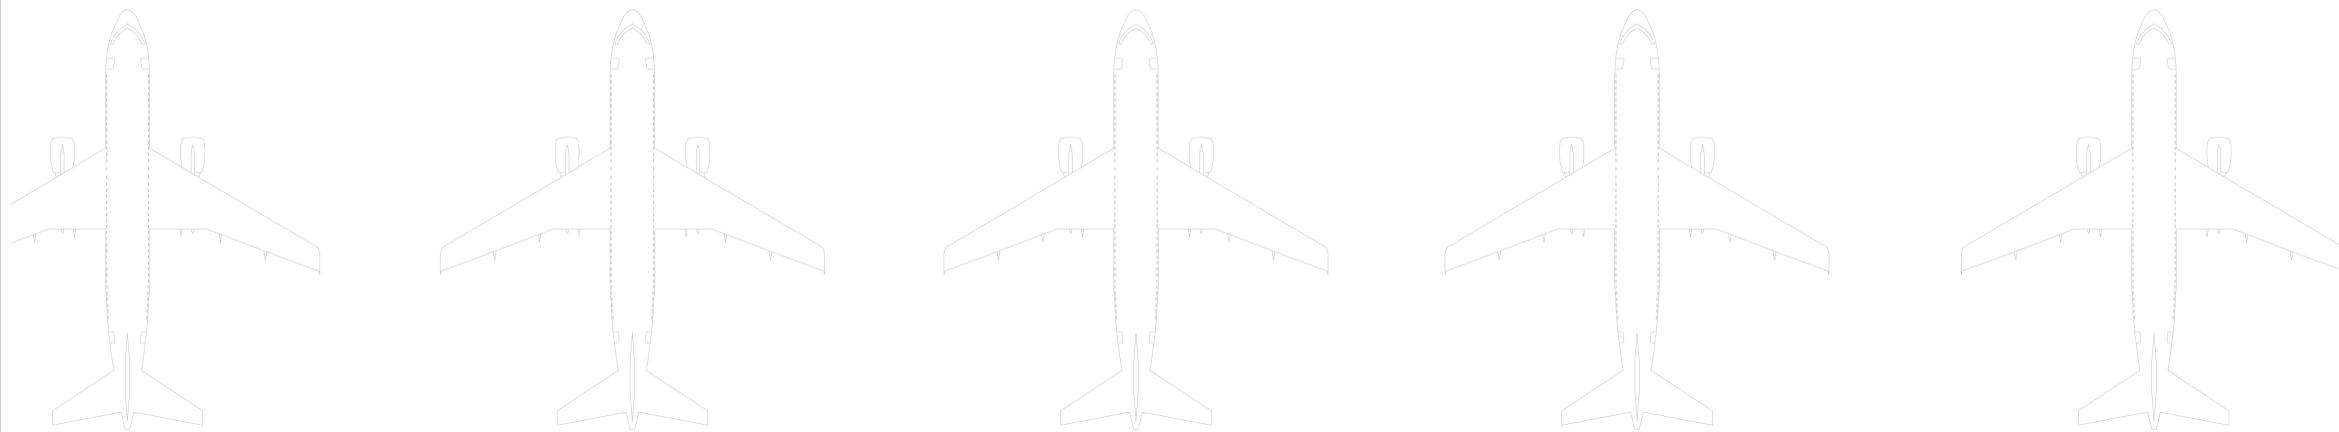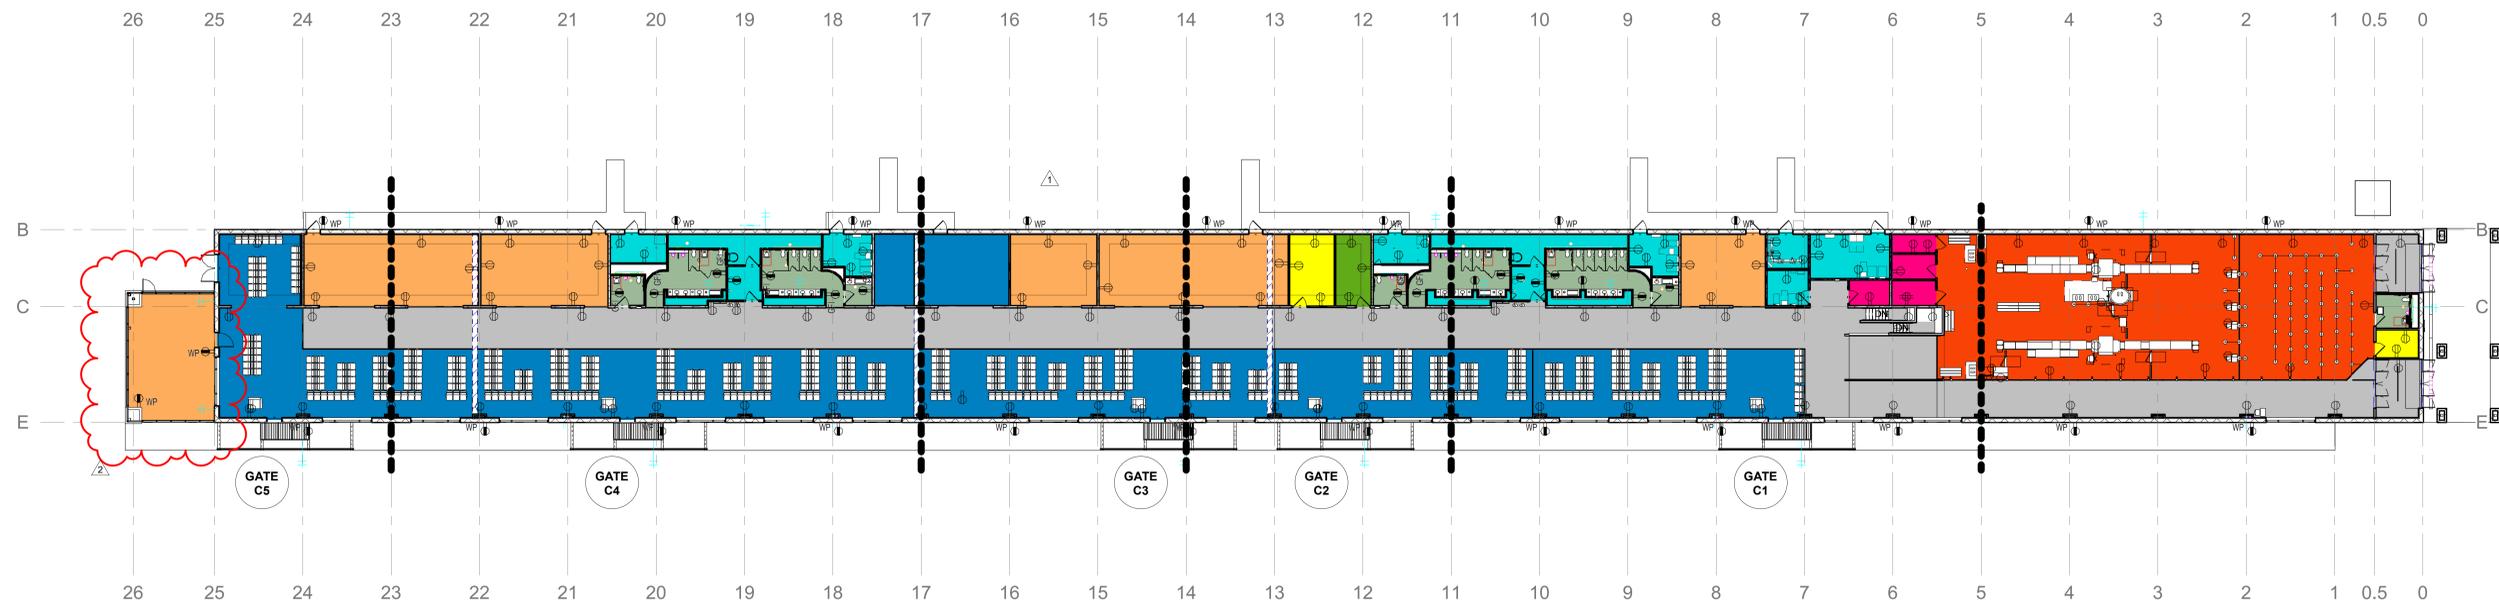

D1 SPACE UTILIZATION PLAN CONCOURSE LEVEL


1" = 20'-0"



SPACE LEGEND

- ADMINISTRATION-AIRPORT (Yellow)
CIRCULATION (Grey)
COMMERCIAL AIRLINE OPERATION - GATES (Blue)
COMMERCIAL AIRLINE OPERATION - OFFICES (Green)
CONCESSIONAIRES (Orange)
RESTROOM (Light Green)
SECURITY - TSA OFFICES (Pink)
SECURITY-PASSENGER SCREENING (Red)
SUPPORT (Cyan)

SHEET PROVIDED FOR INFORMATION ONLY

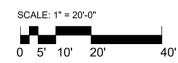

BIM 360/Design of Satellite Concourse/VPS-MLM\_A.rvt

3/10/2020 12:23:00 PM





C19-2811- AP  
Construction  
of Satellite  
Concourse 'C'

668 N. ORLANDO AVE  
SUITE 107  
MADLAND, FL 32751  
407.897.6764 (VOICE)  
407.894.1338 (FAX)  
WWW.MLM-MARTIN.COM  
MLM-MARTIN ARCHITECTS, INC.

MIGUEL A MARTIN  
FL AR-98279



SEAL

Revisions		
No.	Date	Description
2	09-MAR-2020	ADDENDUM 002

Project No.: **MLM-19672**  
Designed By: **MLM, MAM**  
Drawn By: **ST, CC, DM, CB**  
Checked By: **MAM**  
Issue Date: **21-JAN-2020**  
Drawing Scale: **1" = 20'-0"**  
Brawing Title:

**LIFE SAFETY  
OCCUPANT  
LOAD PLAN**  
BID DOCUMENTS

Brawing No.:  
**AL111**

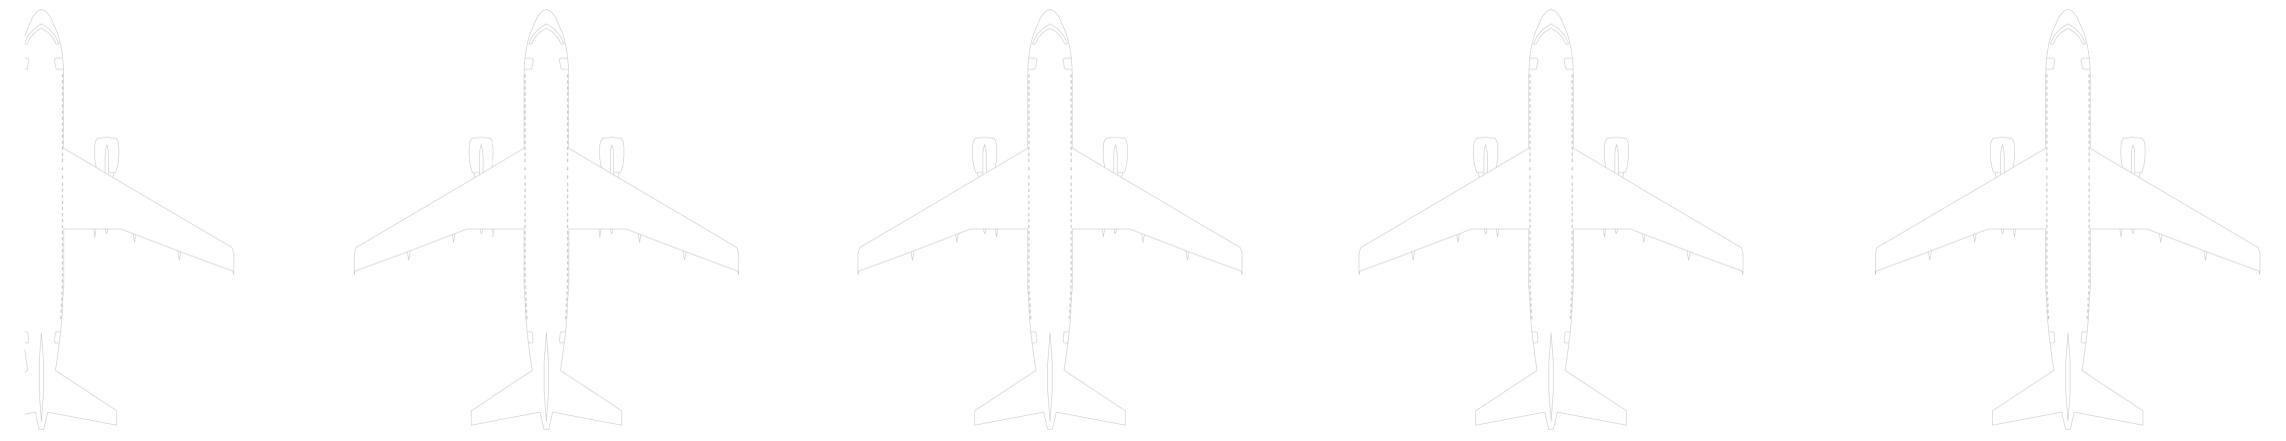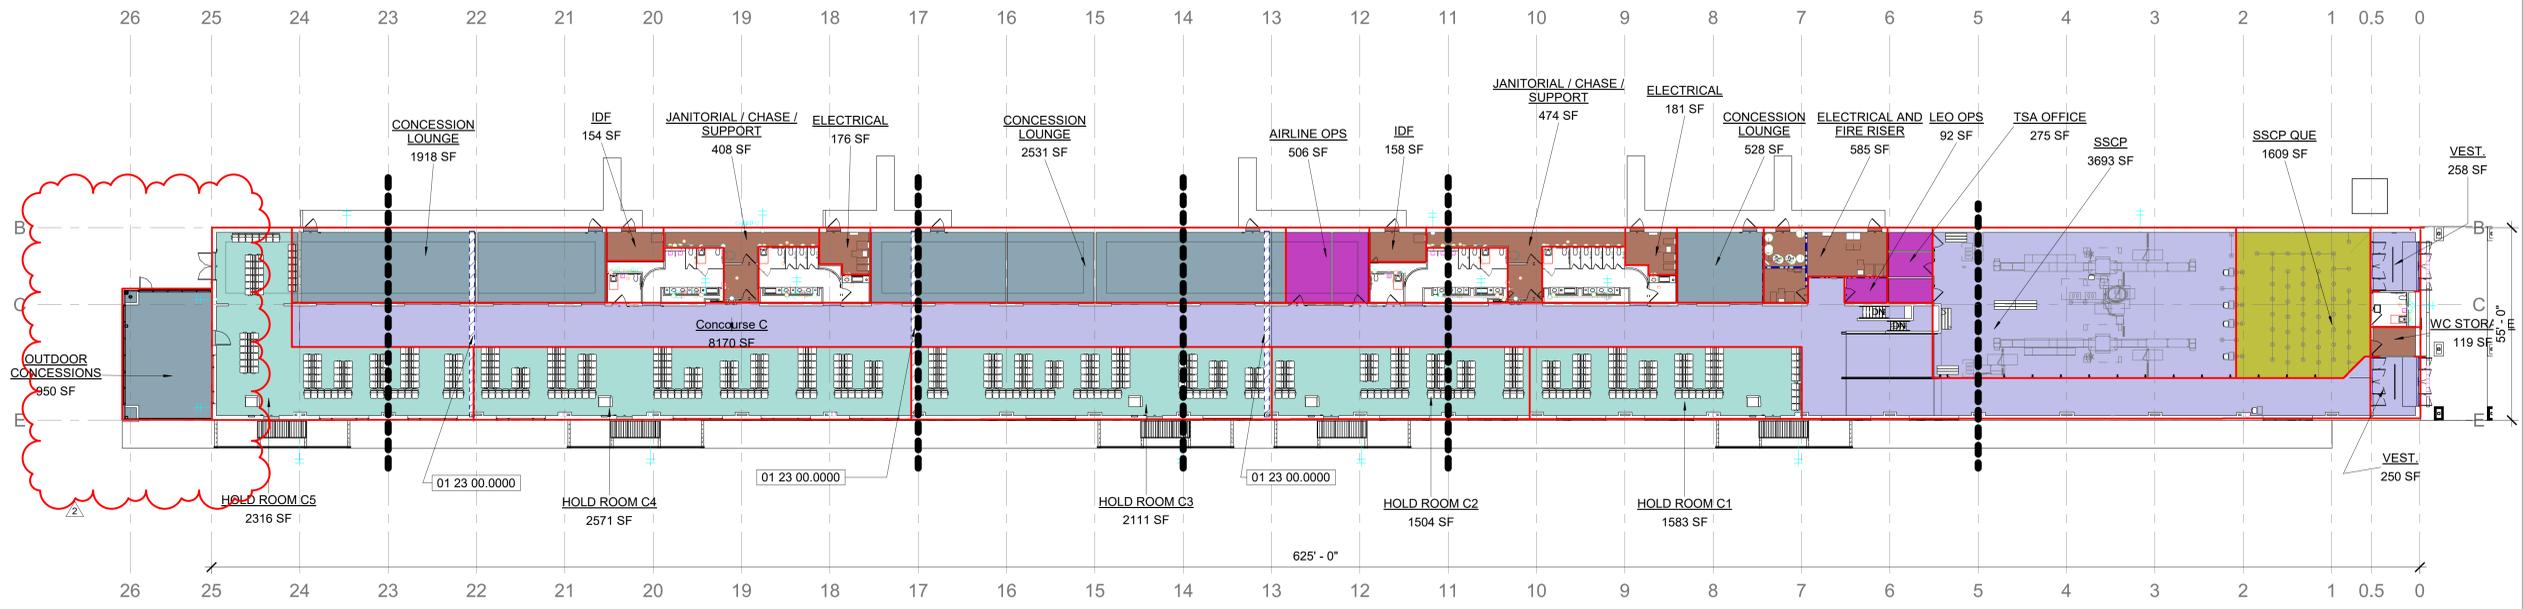

D1 OVERALL OCCUPANCY FUNCTION PLAN  
1" = 20'-0"



FUNCTION LEGEND	
300 SF	Accessory storage areas, mechanical equipment room
100 SF	Business Areas
100 SF	Concourse
5 SF	Standing Space Concentrated
15 SF	Unconcentrated (tables and chairs)
15 SF	Waiting areas

OCCUPANT LOAD (FBC TABLE 1004.1.2)				
Name	Area	Occ Function	Occ Load Factor	Occupant Count
HOLD ROOM C5	2316 SF	Waiting areas	15 SF	155
HOLD ROOM C4	2571 SF	Waiting areas	15 SF	172
HOLD ROOM C3	2111 SF	Waiting areas	15 SF	141
HOLD ROOM C2	1504 SF	Waiting areas	15 SF	101
HOLD ROOM C1	1583 SF	Waiting areas	15 SF	106
AIRLINE OPS	506 SF	Business Areas	100 SF	6
LEO OPS	92 SF	Business Areas	100 SF	1
CONCESSION LOUNGE	2531 SF	Unconcentrated (tables and chairs)	15 SF	169
CONCESSION LOUNGE	528 SF	Unconcentrated (tables and chairs)	15 SF	36
Concourse C	8170 SF	Concourse	100 SF	82
SSCP QUE	1609 SF	Standing Space Concentrated	5 SF	322
IDF	154 SF	Accessory storage areas, mechanical equipment room	300 SF	1
IDF	158 SF	Accessory storage areas, mechanical equipment room	300 SF	1
SSCP	3693 SF	Concourse	100 SF	37
ELECTRICAL AND FIRE RISER	585 SF	Accessory storage areas, mechanical equipment room	300 SF	2
WC STORAGE	119 SF	Accessory storage areas, mechanical equipment room	300 SF	1
VEST.	258 SF	Concourse	100 SF	3
VEST.	250 SF	Concourse	100 SF	3
TSA OFFICE	275 SF	Business Areas	100 SF	3
ELECTRICAL	181 SF	Accessory storage areas, mechanical equipment room	300 SF	1
JANITORIAL / CHASE / SUPPORT	474 SF	Accessory storage areas, mechanical equipment room	300 SF	2
ELECTRICAL	176 SF	Accessory storage areas, mechanical equipment room	300 SF	1
JANITORIAL / CHASE / SUPPORT	408 SF	Accessory storage areas, mechanical equipment room	300 SF	2
CONCESSION LOUNGE	1918 SF	Unconcentrated (tables and chairs)	15 SF	128
OUTDOOR CONCESSIONS	950 SF	Unconcentrated (tables and chairs)	15 SF	64
				1540

**KEYNOTES**

NO. 01 23 00.0000 LIMITS OF ALTERNATE WORK, SEE SPECIFICATIONS FOR MORE INFORMATION.

SCALE: 1" = 20'-0"

3/10/2020 12:19:13 PM BIM 360/Design of Satellite Concourse/VPS-MLM\_A.rvt



C19-2811- AP  
Construction  
of Satellite  
Concourse 'C'



MIGUEL A MARTIN  
FL AR-98279

SEAL

Revisions

No.	Date	Description
2	09-MAR-2020	ADDENDUM 002


Project No.: **MLM-19672**  
Designed By: **MLM, MAM**  
Drawn By: **ST, CC, DM, CB**  
Checked By: **MAM**  
Issue Date: **21-JAN-2020**  
Drawing Scale: **1" = 20'-0"**  
Drawing Title:

EGRESS PLAN

BID DOCUMENTS

Drawing No.:


**AL211**

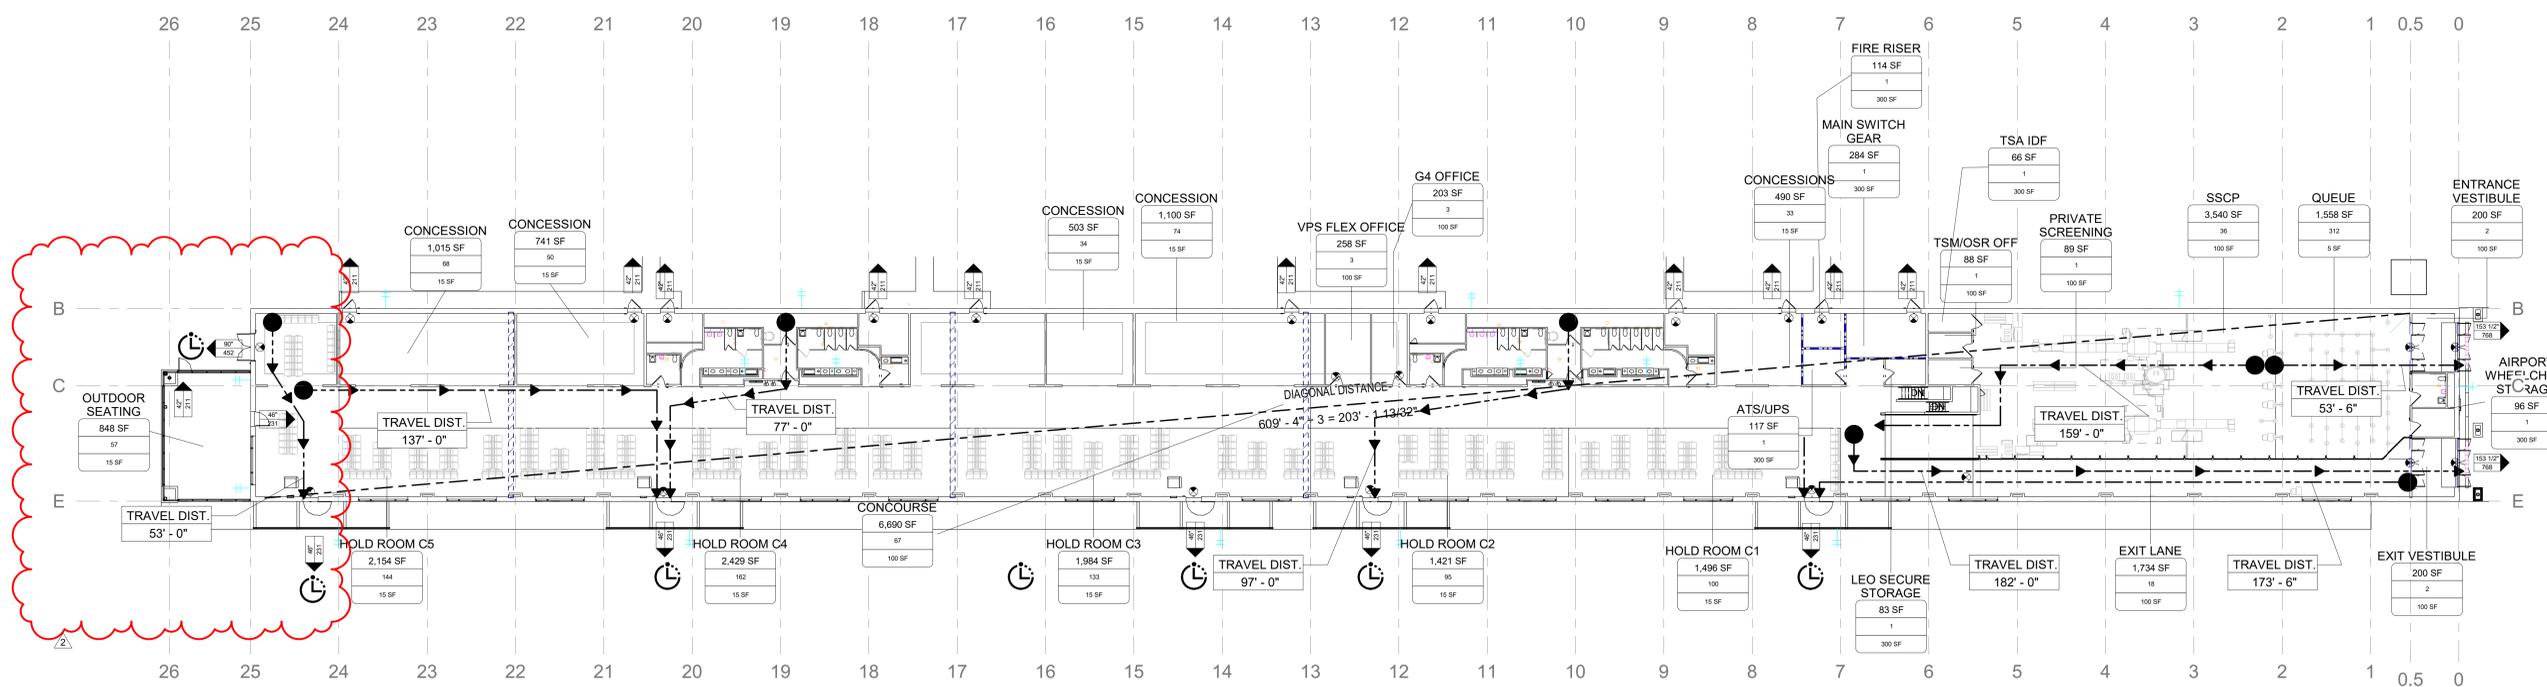

D1 OVERALL EGRESS PLAN  
1" = 20'-0"

EGRESS PLAN LEGEND

- CAPACITY OF EGRESS COMPONENT  
DIRECTION OF TRAVEL  
CLEAR WIDTH  
CAPACITY PER FBC§1005.3.2
- ROOM OCCUPANT LOAD FBC§1005.3  
AREA OF ROOM/SPACE  
REQ'D OCCUPANT LOAD CAPACITY  
OCCUPANT LOAD FACTOR FBC§  
1004.1.2 - SEE SHEET AL111
- EXIT TRAVEL DISTANCE FBC§1017.2  
TRAVEL DISTANCE  
POINT OF BEGINNING  
POINT OF DISCHARGE  
PATH OF TRAVEL
- DIAGONAL DISTANCE  
DOORWAY CONFIG. FBC§1007.1.1  
MEASURABLE DISTANCE  
MINIMUM DISTANCE BETWEEN EXITS  
FBC§1007.1.1-EXCEPTION 2
- EXIT SIGN FBC §1013  
ILLUMINATED FACE FBC §1013.3  
DIRECTIONAL GRAPHICS
- DELAYED EGRESS INDICATION

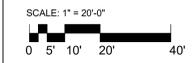

DISTANCE LIMITATIONS

OCCUPANCY	MAXIMUM TRAVEL DISTANCE TO EXIT (FBC TABLE 1017.2)	MAXIMUM DEAD-END CORRIDOR LENGTH (FBC TABLE 1020.4)	MAXIMUM COMMON PATH OF TRAVEL (FBC TABLE 1006.2.1)
ASSEMBLY (A)	250'	20'	75'
BUSINESS (B)	300'	50' (1020.4(2))	100'
MERCANTILE (M)	250'	50' (1020.4(2))	75'


QUANTITY OF MEANS OF EGRESS

FBC 1006.3.1 MINIMUM NUMBER OF EXITS REQUIRED: 4  
NUMBER OF EXITS PROVIDED: 8

3/10/2020 12:19:33 PM BIM 360/Design of Satellite Concourse/VPS-MLM\_A.rvt





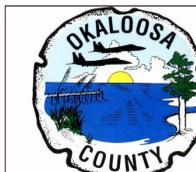

**C19-2811-AP**  
Construction  
of Satellite  
Concourse 'C'

668 N. ORLANDO AVE.  
SUITE 107  
MAITLAND, FL 32751  
407.897.6764 (VOICE)  
407.894.1338 (FAX)  
WWW.MLM-MARTIN.COM  
AA-C002208  
MLM JOB # TYPE PROPERTY

SEAL

Revisions

No.	Date	Description
1	3/09/2020	Addendum No.002

**INFRASTRUCTURE**  
CONSULTING & ENGINEERING  
5550 WEST IDLEWILD AVE. SUITE 115  
TAMPA, FLORIDA 33634 (813) 330-2701  
CERTIFICATE OF AUTHORIZATION NO.: 30862





Project No.: **MLM-19672**  
Designed By: **JG**  
Drawn By: **MA, AM**  
Checked By: **DH**  
Issue Date: **21-JAN-2020**  
Drawing Scale: **1" = 20'-0"**  
Drawing Title:

**SITE UTILITIES PLAN**

BID DOCUMENTS

Drawing No.:

**C2.0**

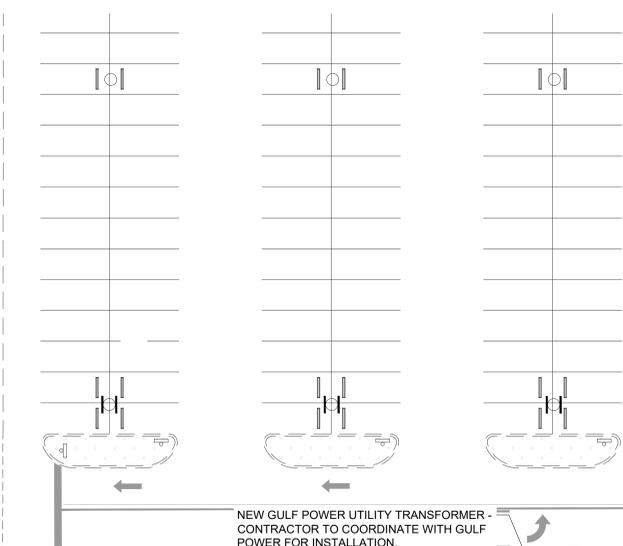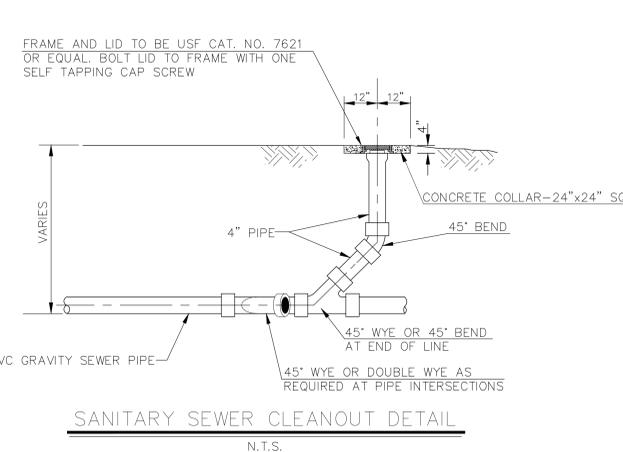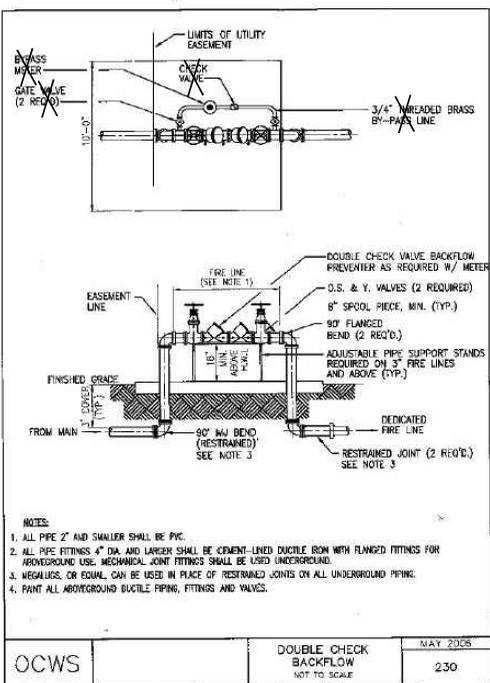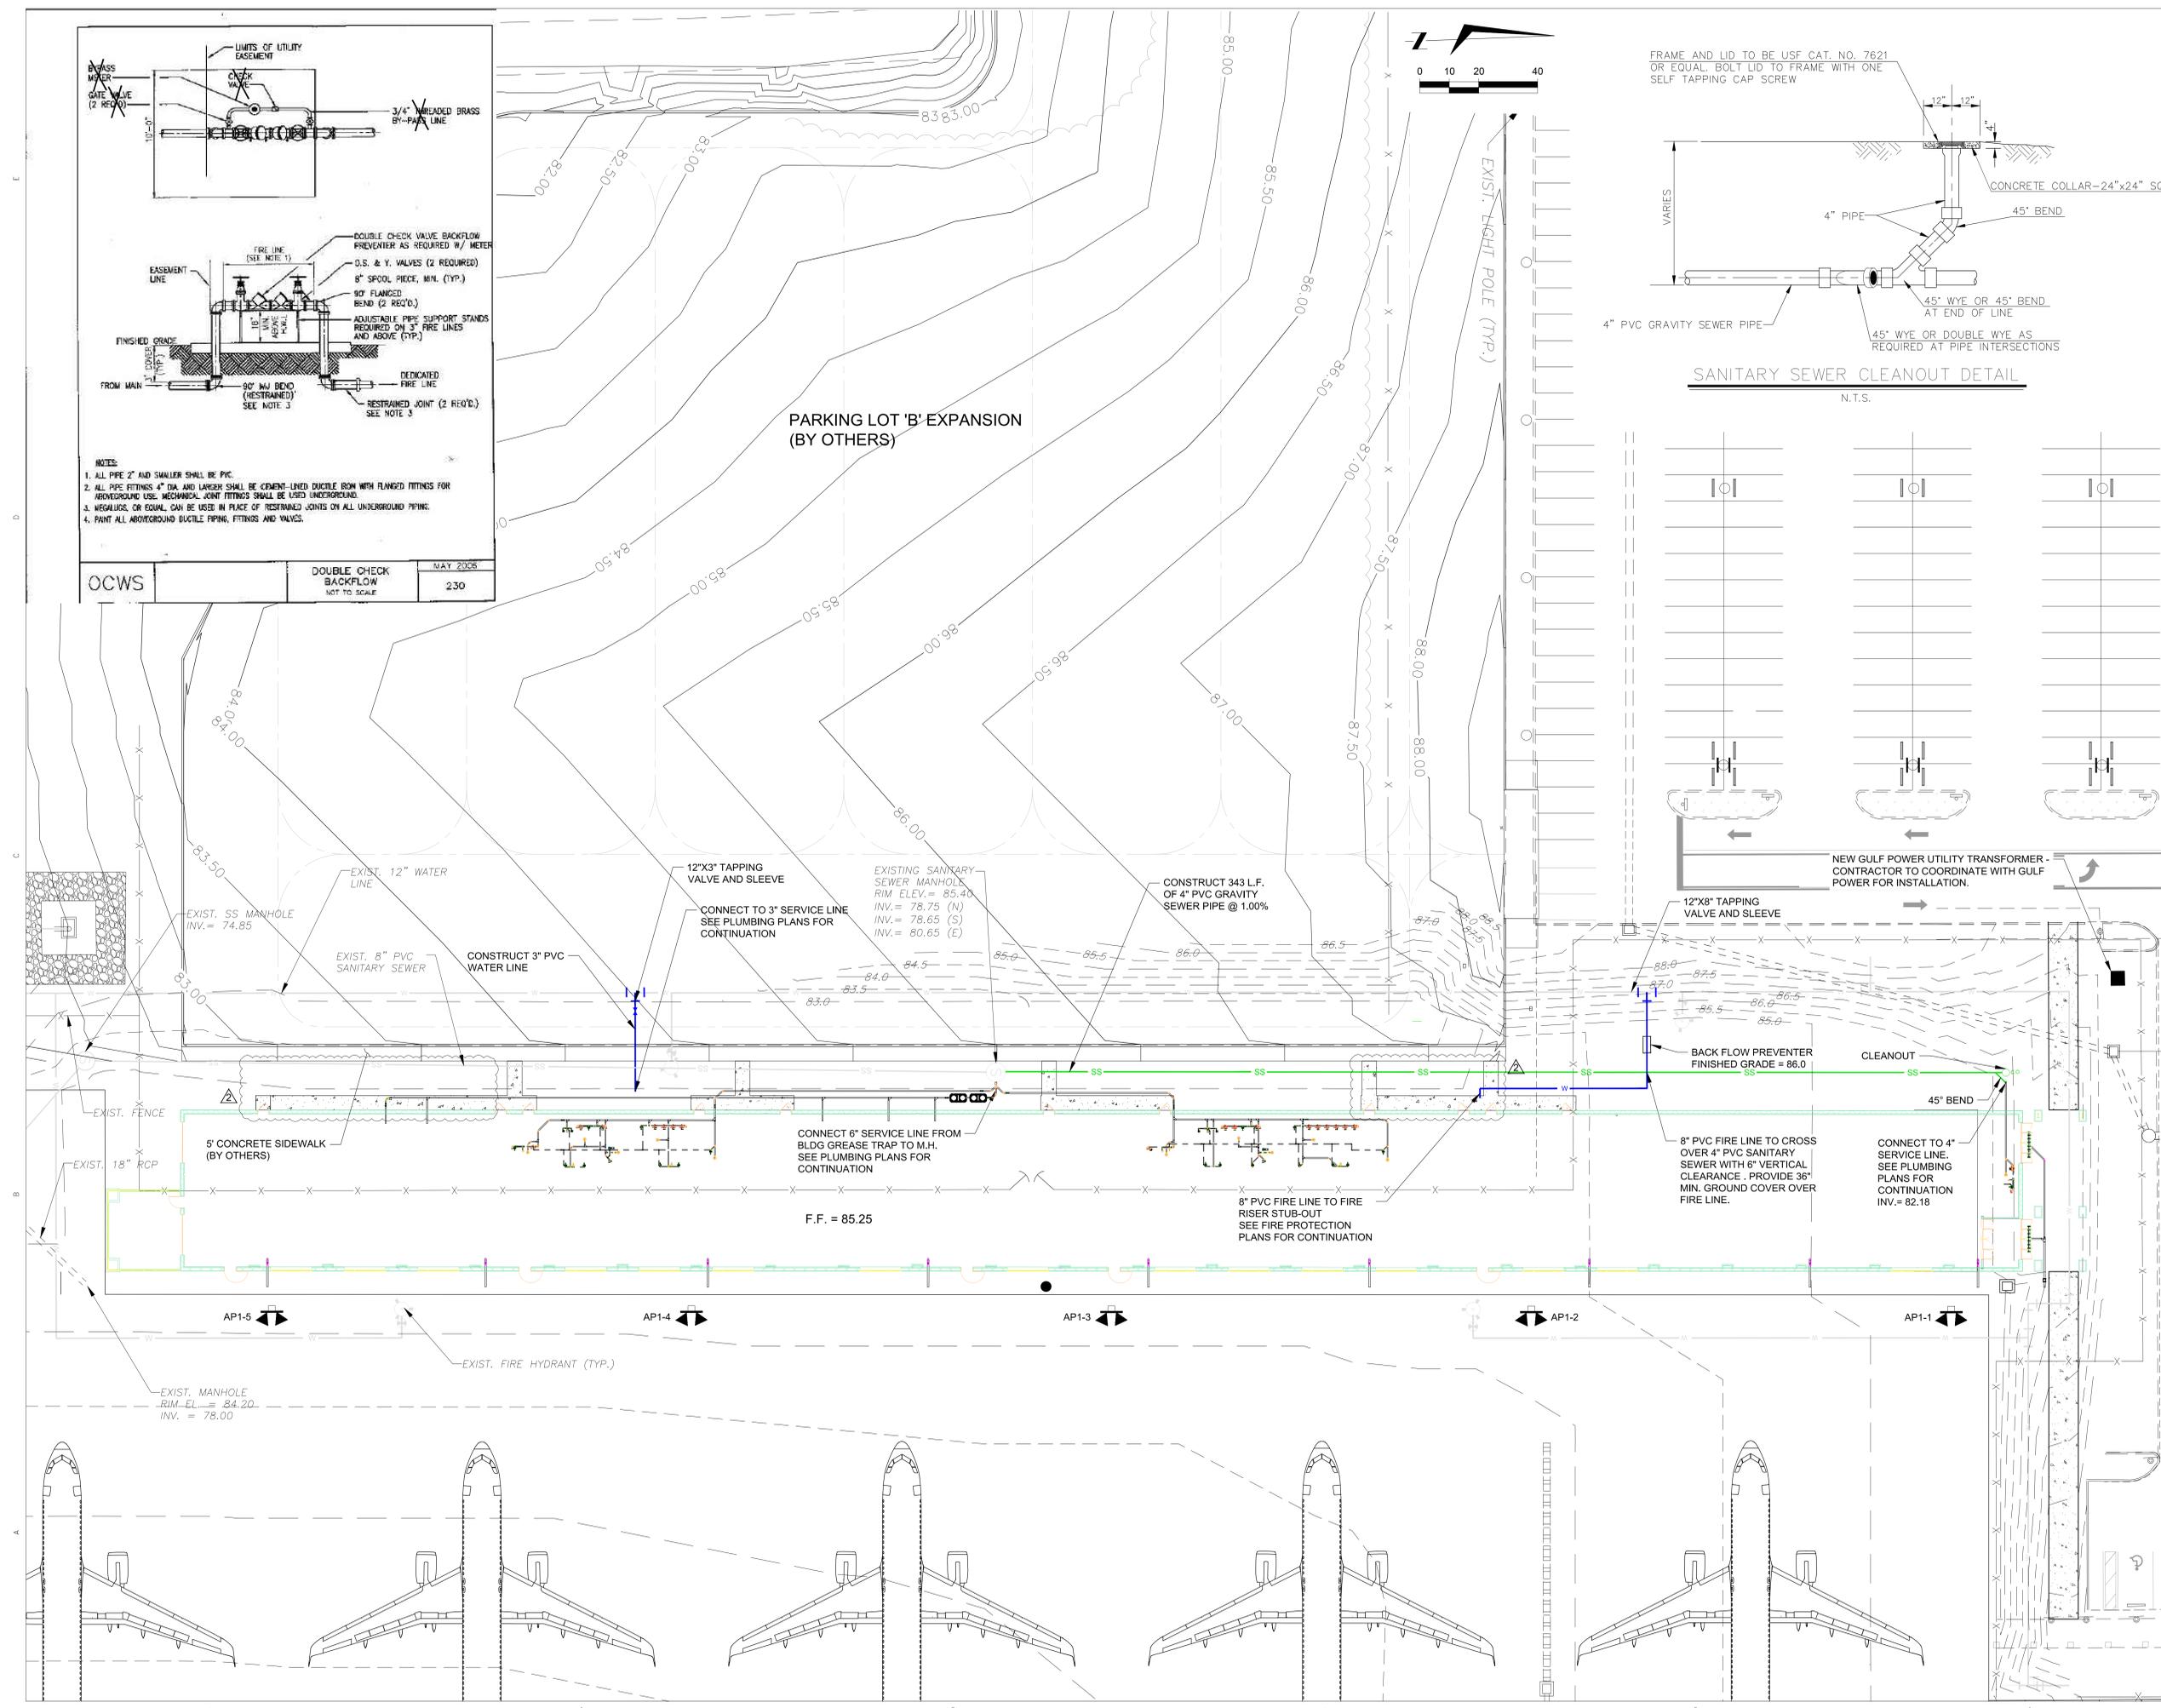

OCWS	DOUBLE CHECK BACKFLOW NOT TO SCALE	MAY 2006	230
------	------------------------------------	----------	-----



C19-2811-AP  
Construction  
of Satellite  
Concourse 'C'



668 N. ORLANDO AVE.  
SUITE 107  
MAITLAND, FL 32751  
407.897.6764 (VOICE)  
407.894.1338 (FAX)  
WWW.MLM-MARTIN.COM  
AA-C00208  
SEAL FOR S-TYPE PROPERTY

C:\Users\jmartin\Desktop\AP19-2811\191111.dwg

SEAL

Revisions

No.	Date	Description
1	3/09/2020	Addendum No.002



5550 WEST IDLEWILD AVE. SUITE 115  
TAMPA, FLORIDA 33634 (813) 330-2701  
CERTIFICATE OF AUTHORIZATION NO.: 30862



Project No.: **MLM-19672**  
Designed By: **JG**  
Drawn By: **MA, AM**  
Checked By: **DH**  
Issue Date: **21-JAN-2020**  
Drawing Scale: **1" = 20'-0"**  
Drawing Title:

**FENCING PLAN**

BID DOCUMENTS

Drawing No.:

**C3.0**

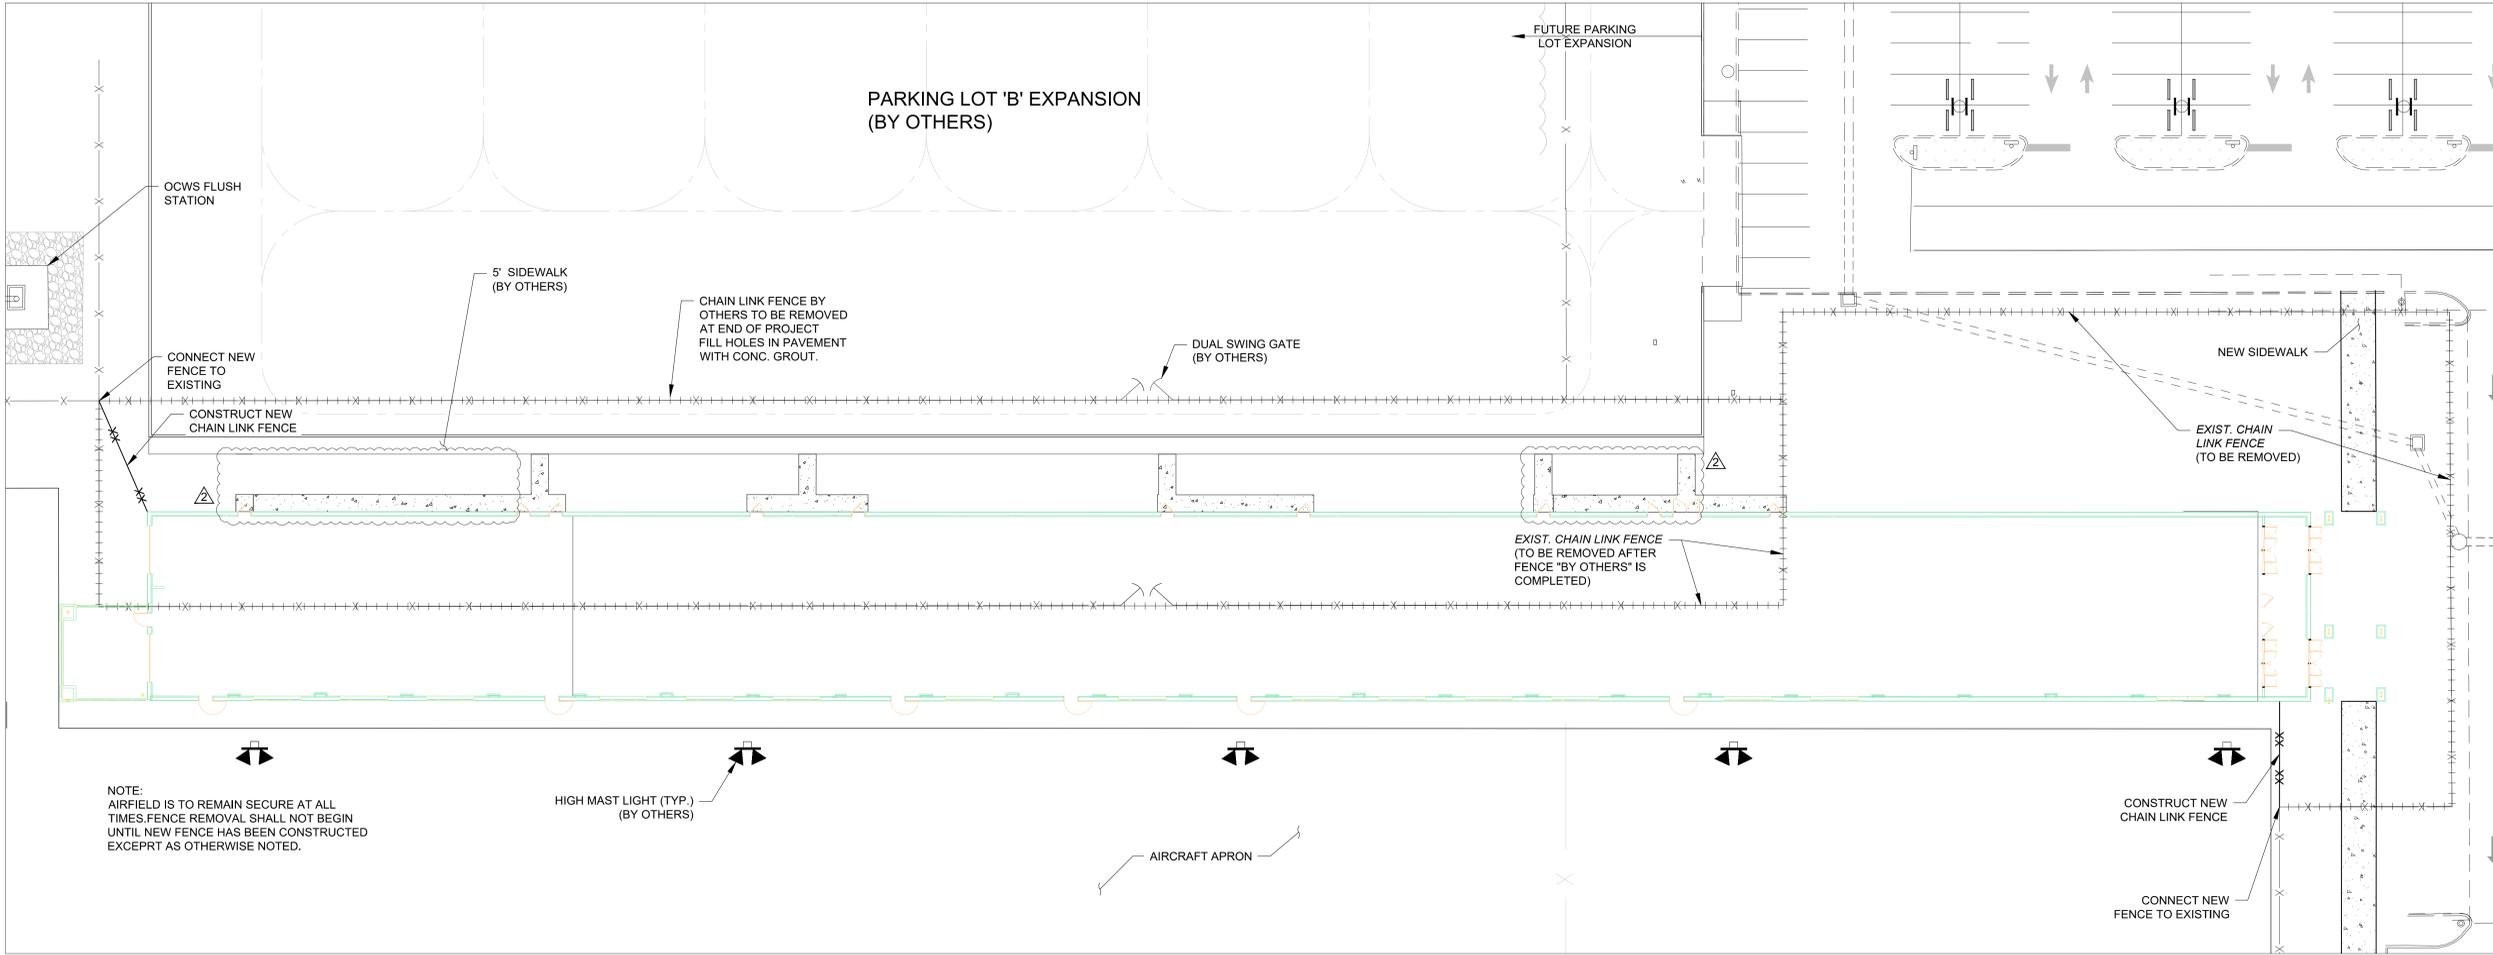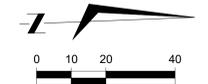

E  
D  
C  
B  
A

1 2 3 4 5 6



C19-2811- AP  
Construction  
of Satellite  
Concourse 'C'



MIGUEL A MARTIN  
FL AR-98279

SEAL

Revisions


No.	Date	Description
2	09-MAR-2020	ADDENDUM 002

Project No.: **MLM-19672**  
Designed By: **MLM, MAM**  
Drawn By: **ST, CC, DM, CB**  
Checked By: **MAM**  
Issue Date: **21-JAN-2020**  
Drawing Scale: **1" = 20'-0"**  
Drawing Title:


**OVERALL  
CONCOURSE  
PLANS**  
BID DOCUMENTS

Drawing No.:

**A110**

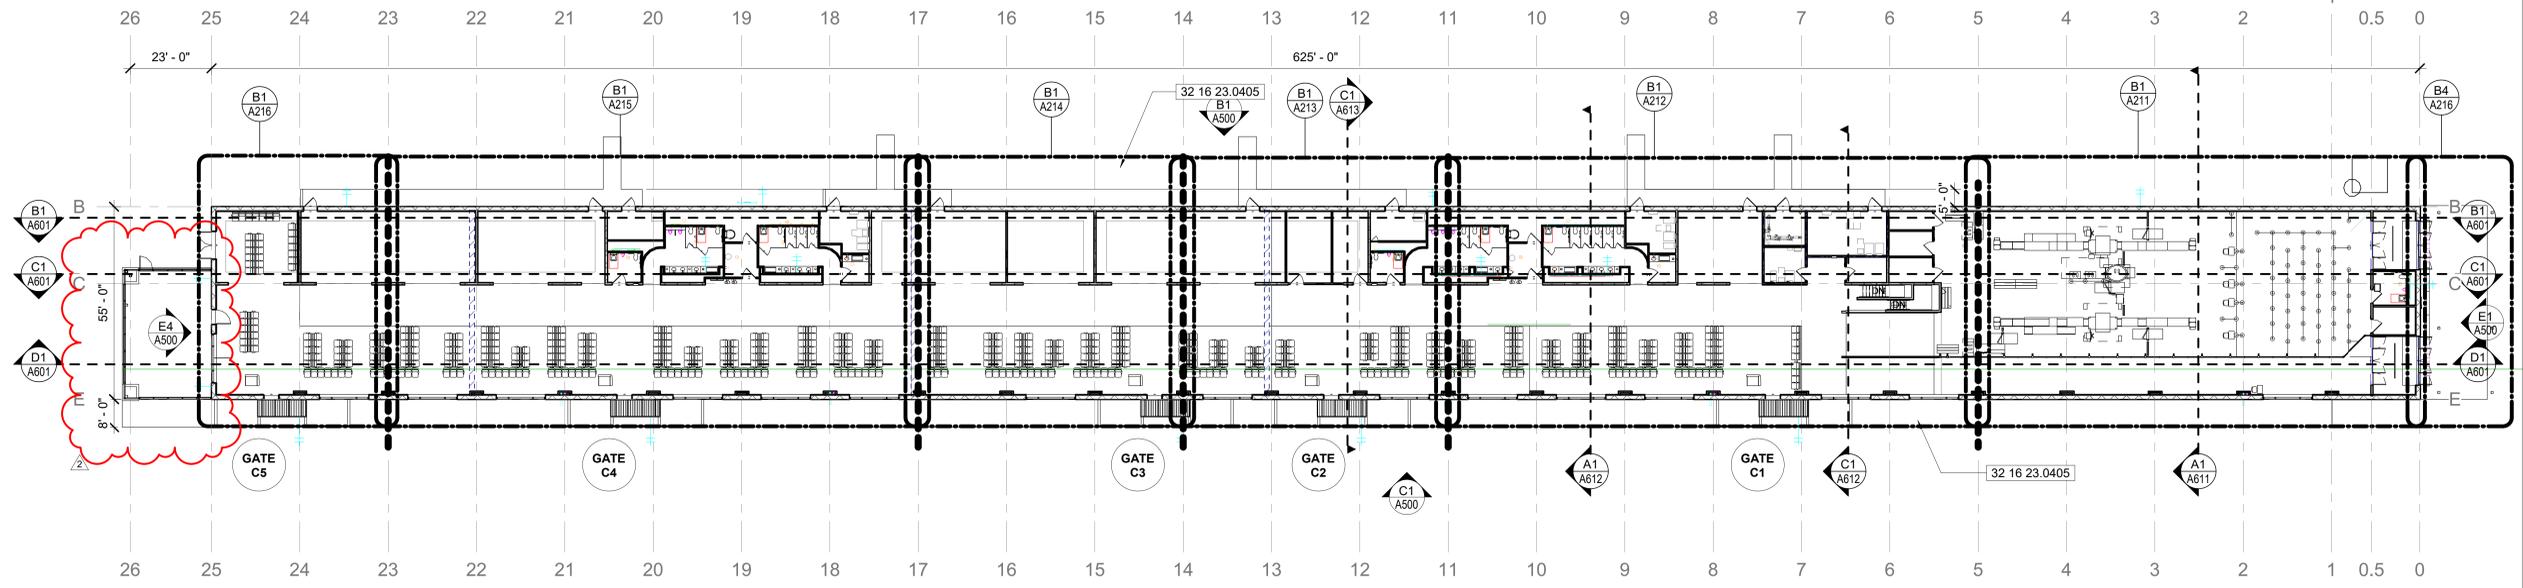

D1 OVERALL PLAN CONCOURSE LEVEL  
1" = 20'-0"

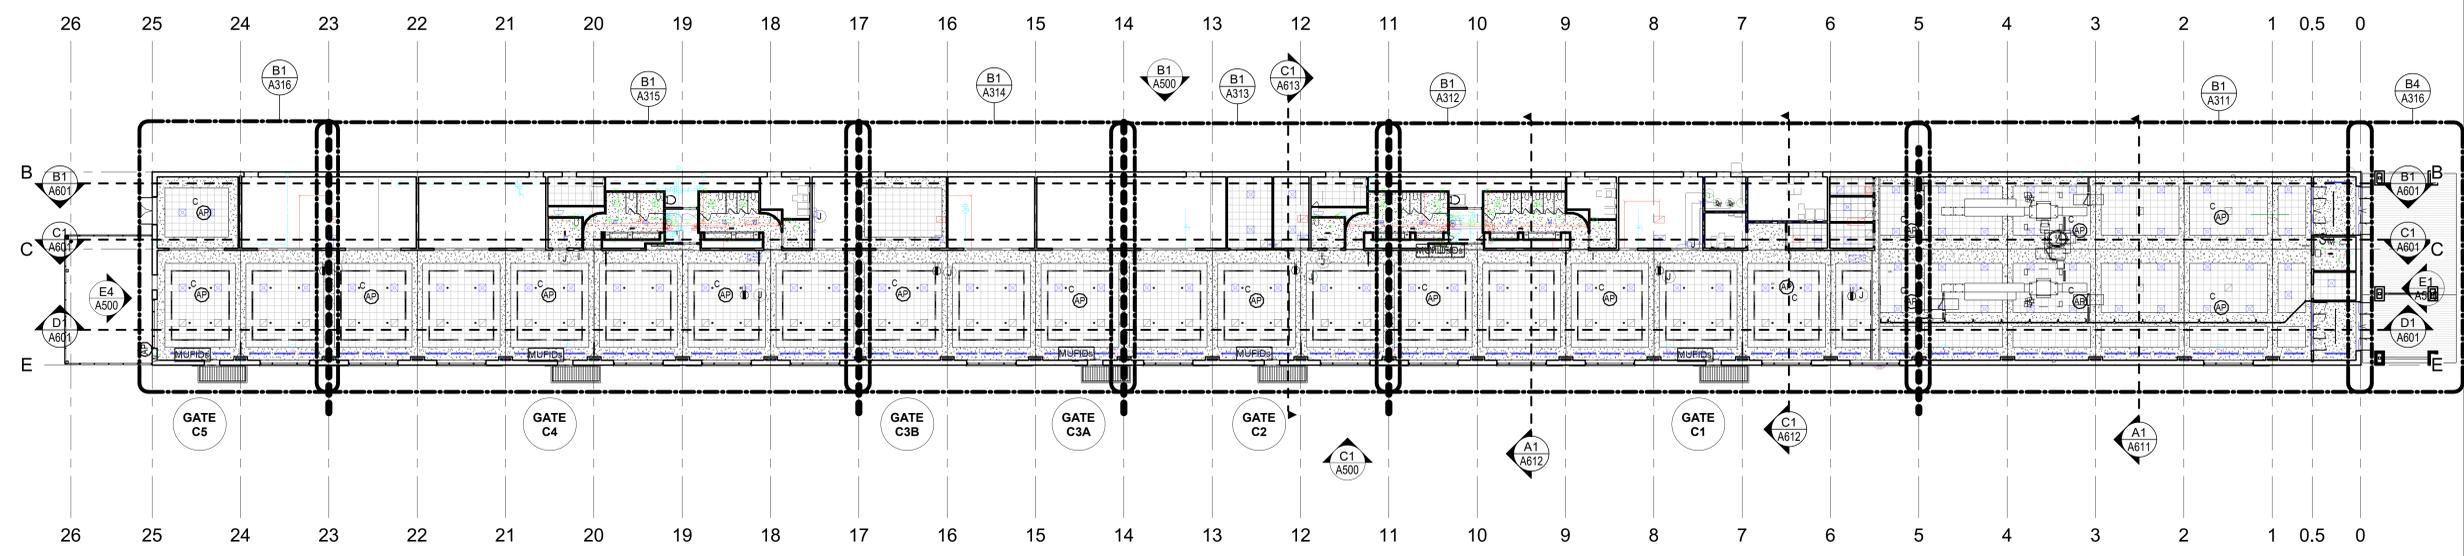

A1 OVERALL CEILING PLAN CONCOURSE LEVEL  
1" = 20'-0"




**KEYNOTES**

NO.	DESCRIPTION
32 16 23.0405	TYP. 4" BROOM FINISHED CONCRETE SIDEWALK.




BIM 360/Design of Satellite Concourse/VPS-MLM\_A.rvt

3/10/2020 12:14:37 PM

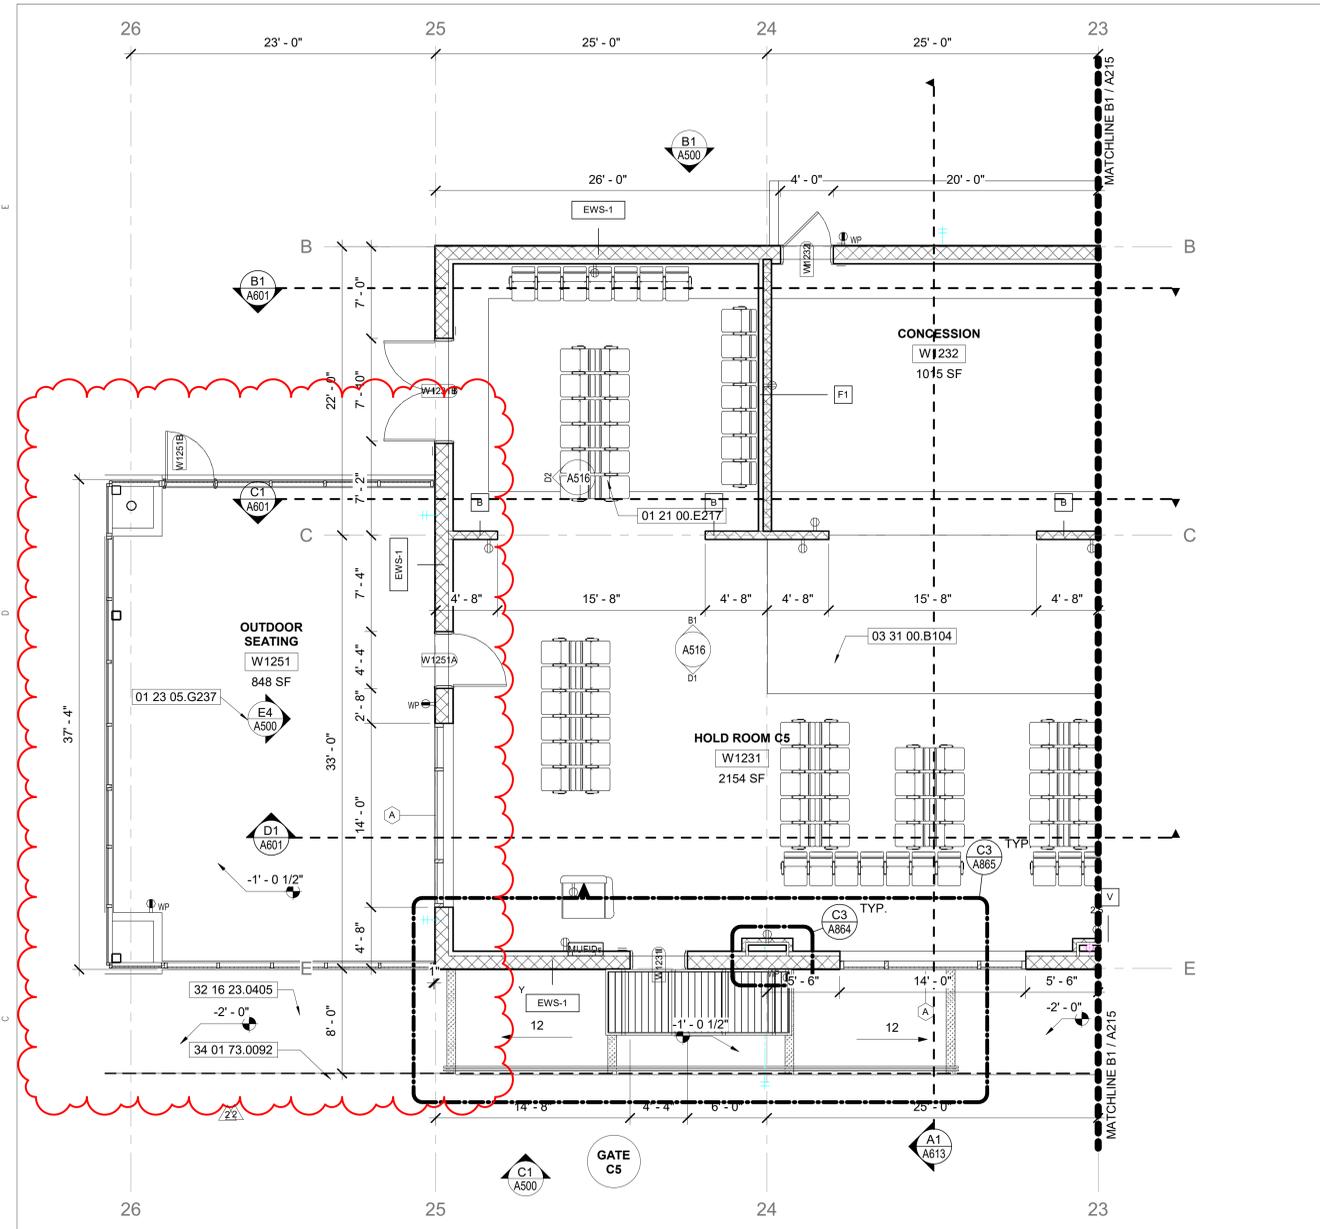

**B1** CONCOURSE LEVEL AREA 6 PLAN  
3/16" = 1'-0"

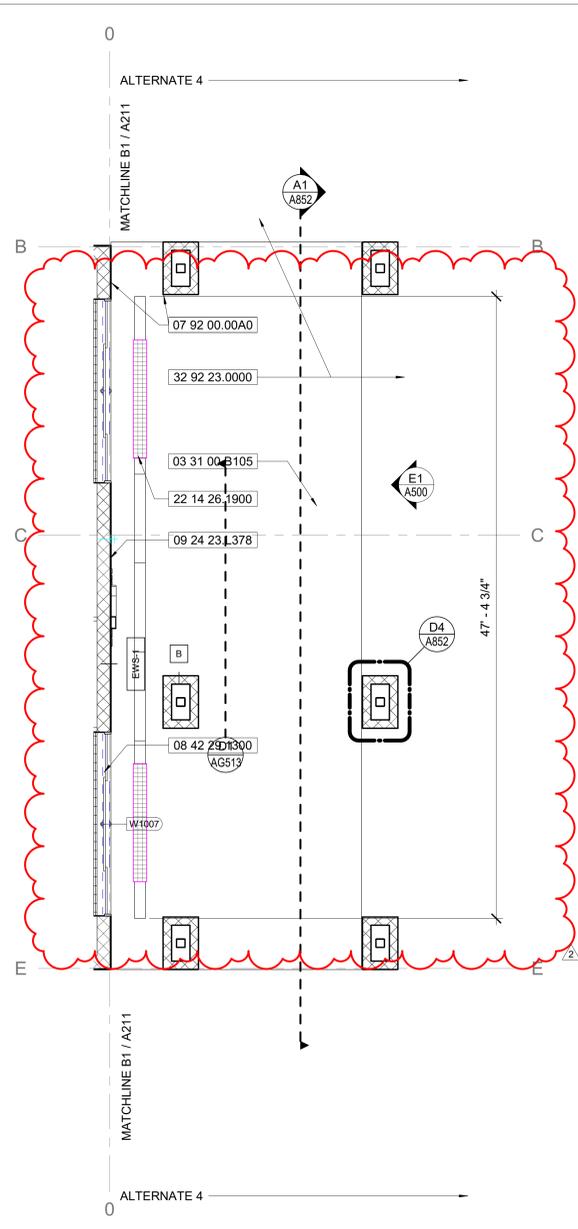

**B4** ALTERNATE 4 PLAN  
3/16" = 1'-0"




**KEYNOTES**

- | NO.           | DESCRIPTION   |
|---------------|---|
| 01 21 00.E217 | TYP. ALLOWANCE FOR FIXED MULTIPLE SEATING WORK.   |
| 01 23 05.G237 | TYP. ALTERNATE 5 EXTERIOR CONCESSIONS PLAZA WORK.   |
| 03 31 00.B104 | TYP. 4" STRUCTURAL SLAB-ON-GRADE, SEE STRUCTURAL.   |
| 03 31 00.B105 | TYP. 5" CONCRETE FLOOR SLAB, SEE STRUCTURAL.  |
| 07 92 00.00A0 | TYP. JOINT SEALANT, FULL PERIMETER.   |
| 08 42 29.1300 | TYP. ALUMINUM FRAMED AUTOMATIC ENTRANCE DOOR.   |
| 09 24 23.L378 | TYP. SMOOTH 7/8" STUCCO, 3 COAT SYSTEM  |
| 22 14 26.1900 | TYP. FACILITY STORM TRENCH DRAIN, SEE PLUMBING.   |
| 32 16 23.0405 | TYP. 4" BROOM FINISHED CONCRETE SIDEWALK.   |
| 32 92 23.0000 | TYP. SODDING AND PLANTING SEE LANDSCAPE.  |
| 34 01 73.0092 | TYP. PRESERVE EDGE OF AIRFIELD CONSTRUCTION. COORDINATE PROTECTION OF BUILT ELEMENTS WITH ADJACENT PROJECT. |

**NOTES**

- REFER TO **AL641** FOR PARTITION TYPES
- ALL PARTITIONS ARE DIMENSIONED FROM FACE OF FINISH TO FACE OF FINISH U.O.N.
- ALL WALL PARTITIONS TO BE FULL HEIGHT U.O.N.
- REFER TO **AG** SERIES SHEETS FOR WAYFINDING AND SIGNAGE.
- MAINTAIN 1/16" SLOPE MINIMUM AND 1/4" SLOPE MAXIMUM TO AREA DRAINS
- FOR FIRE EXTINGUISHER DETAILS REFER TO **AL710**
- FOR DOOR TYPES AND SCHEDULES REFER TO SHEET SERIES **AT11**
- HINGE DOORS SIDE OF DOORS TO BE LOCATED PER DETAILS FROM FACE OF ADJACENT PERPENDICULAR PARTITIONS U.O.N.
- REFER TO ELECTRICAL, TELECOM, AV, AND SIGNAGE DRAWINGS FOR OUTLET INFORMATION.
- FOR RAILING DETAILS REFER TO SHEET **AB65**
- REFER TO **AF** SERIES SHEETS FOR FINISH INFORMATION.
- SHORT-APPLIED GALVANIZATION FOR METAL. TOUCH UP ALL DAMAGED GALVANIZATION WITHIN 24HRS OF ERECTION
- CONTRACTOR TO PROVIDE SIGNED AND SEALED DRAWINGS AND LOAD CALCULATIONS IN COMPLIANCE WITH FLORIDA BUILDING CODE WITH SUPPLEMENTS FOR ALL FABRICATED STAIRS, LADDERS, GRAB BARS, GUARDS, HANDRAILS AND/OR PLATFORMS. MINIMUM 50 PLF AND 200 POUND CONCENTRATED DESIGN LOADS.
- AREA DESIGNATED FOR FUTURE WORK (NIC), CONTRACTOR SHALL KEEP THIS AREA CLEAR OF ANY BUILT ELEMENTS ABOVE AND/OR BELOW GROUND UNLESS OTHERWISE NOTED WITHIN THE SCOPE OF THIS PROJECT.
- CONCESSION AREAS SHALL BE FIT OUT AS SHELL SPACES WITH CODE MINIMUM SYSTEMS SUPPORT AS INDICATED.

LIFE SAFETY LEGEND  
 RATED FIRE PARTITIONS  
 1 = 1 HOUR FIRE PARTITION  
 2 = 2 HOUR FIRE PARTITION

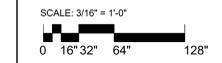

**C19-2811- AP**  
 Construction  
 of Satellite  
 Concourse 'C'



**MIGUEL A MARTIN**  
 FL AR-98279

SEAL


**Revisions**

No.	Date	Description
2	09-MAR-2020	ADDENDUM 002

Project No.: **MLM-19672**  
 Designed By: **MLM, MAM**  
 Drawn By: **ST, CC, DM, CB**  
 Checked By: **MAM**  
 Issue Date: **21-JAN-2020**  
 Drawing Scale: **As indicated**  
 Drawing Title:


**ENLARGED FLOOR PLAN - AREA 6**  
 BID DOCUMENTS

Drawing No.: **A216**

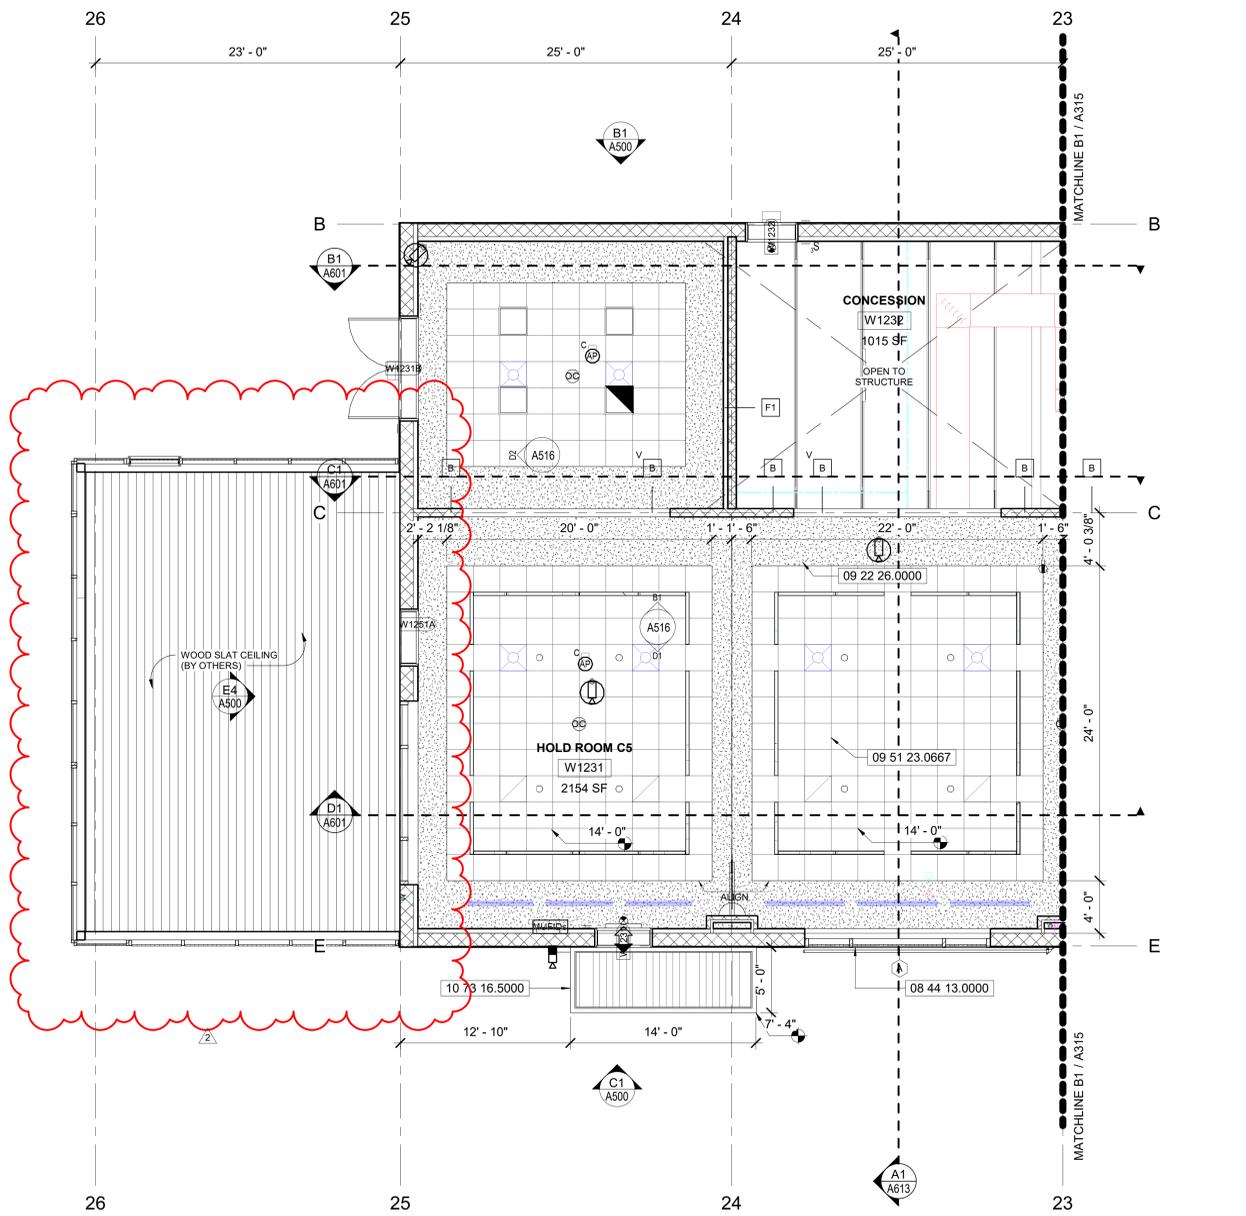

**B1 CEILING AREA PLAN**

3/16" = 1'-0"

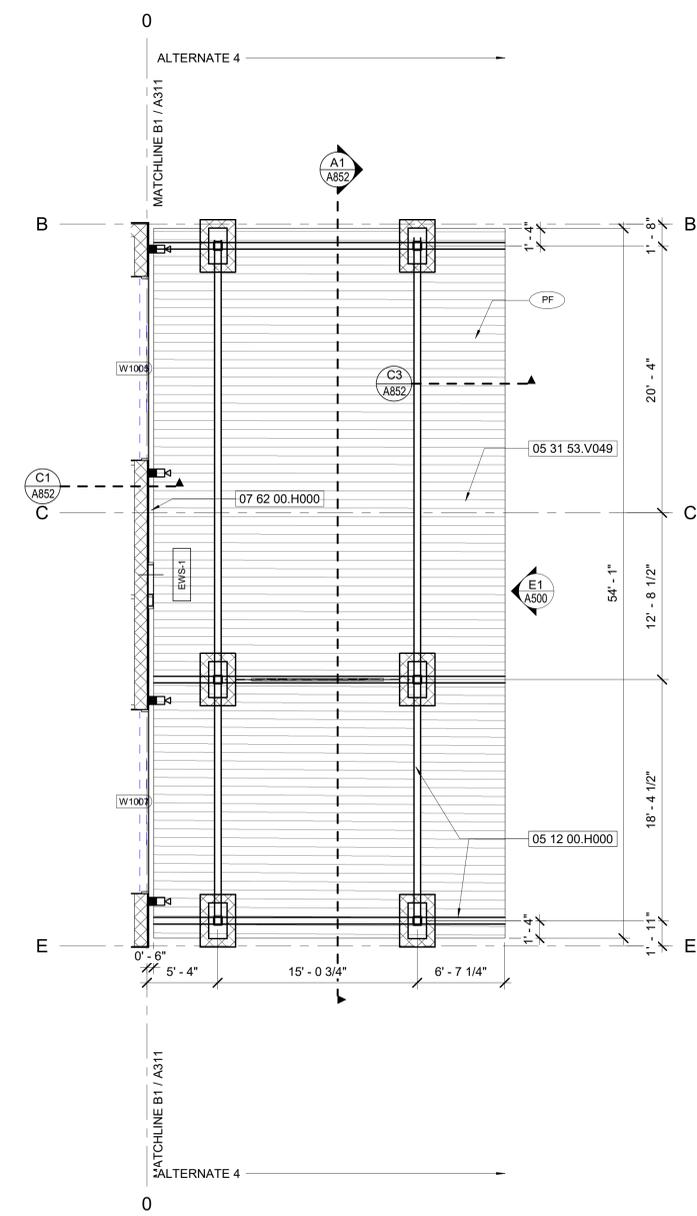

**B4 ALTERNATE 4 CEILING PLAN**

3/16" = 1'-0"



**KEYNOTES**

- NO. 05 12 00.H000 TYP. HSS SHAPE STRUCTURAL STEEL FRAMING, SEE STRUCTURAL.
- 05 31 53.V049 TYP. 4" DOVETAIL G-90 GALV. STEEL ARCHITECTURALLY EXPOSED DECK. BASIS OF DESIGN: EPIC TORIS 4 - CANOPY.
- 07 62 00.H000 TYP. 8" X 6" BEVELED ALUMINUM GUTTER.
- 08 44 13.0000 TYP. GLAZED ALUMINUM CUTAIN WALL ASSEMBLY.
- 09 22 26.0000 TYP. GYPSUM ASSEMBLY SUSPENSION SYSTEM, INSTALL PER MNFR. INSTRUCTIONS.
- 09 51 23.0667 TYP. STANDARD, 24" X 24" REGULAR ACOUSTICAL TILE CEILING SYSTEM.
- 10 73 16.5000 TYP. PREMANUFACTURED ALUMINUM CANOPY SYSTEM. PROVIDE SIGNED & SEALED CALCULATIONS/SHOPDRAWINGS COMPLYING W/ STRUCTURAL DESIGN LOADS.


**NOTES**

1. REFER TO A441 FOR PARTITION TYPES
2. ALL PARTITIONS ARE DIMENSIONED FROM FACE OF FINISH TO FACE OF FINISH U.O.N.
3. ALL WALL PARTITIONS TO BE FULL HEIGHT U.O.N.
4. REFER TO A6 SERIES SHEETS FOR WAYFINDING AND SIGNAGE.
5. FOR DOOR TYPES AND SCHEDULES REFER TO SHEET SERIES A711
6. REFER TO ELECTRICAL, TELECOM, AV, AND SIGNAGE DRAWINGS FOR OUTLET INFORMATION.
7. REFER TO AF SERIES SHEETS FOR FINISH INFORMATION.
8. AREA DESIGNATED FOR FUTURE WORK (INC). CONTRACTOR SHALL KEEP THIS AREA CLEAR OF ANY BUILT ELEMENTS ABOVE AND/OR BELOW GROUND UNLESS OTHERWISE NOTED WITHIN THE SCOPE OF THIS PROJECT.
9. CONCESSION AREAS SHALL BE FIT OUT AS SHELL SPACES WITH CODE MINIMUM SYSTEMS SUPPORT AS INDICATED.

**CEILING LEGEND**

- 24" X 24" ACOUSTICAL TILE CEILING SYSTEM
- ALUMINUM COMPOSITE PANEL EXTERIOR SOFFIT
- SUSPENDED GYPSUM WALL BOARD ASSEMBLY
- DIFFUSER / LINEAR, SEE MECH
- SUPPLY / RETURN DIFFUSER, SEE MECH
- LIGHT FIXTURES, SEE ELEC

- ELEVATIONS PROVIDED FROM CONCOURSE LEVEL
- 1 HR RATED ASSEMBLY
- 2 HR RATED ASSEMBLY

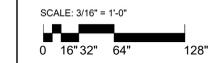

**C19-2811- AP**  
Construction  
of Satellite  
Concourse 'C'



**MIGUEL A MARTIN**  
FL AR-98279

SEAL

Revisions

No.	Date	Description
2	09-MAR-2020	ADDENDUM 002

Project No.: **MLM-19672**  
 Designed By: **MLM, MAM**  
 Drawn By: **ST, CC, DM, CB**  
 Checked By: **MAM**  
 Issue Date: **21-JAN-2020**  
 Drawing Scale: **3/16" = 1'-0"**  
 Drawing Title:

**ENLARGED  
CEILING PLAN -  
AREA 6**  
BID DOCUMENTS

Drawing No.:  
**A316**






**DOOR SCHEDULE**


REV	MARK	ROOM NO	TYPE	DOOR						FRAME			THRESHOLD		COMMENTS	HARWARE SET	
				NUMBER OF LEAFS	WIDTH	HEIGHT	THICKNESS	MATERIAL	FIRE RATING	TYPE	DETAIL	MATERIAL	DETAIL	MATERIAL			
00 Base Bid																	
No	W1001B	W1001	F	1	3'-8"	7'-8"	1 3/4"	HM	NONE	ii	B4/B5	HM		ALUM		7	
No	W1003	W1003	F	1	3'-8"	7'-10"	1 3/4"	HM	NONE	i	D4/D5 SIM.	HM		ALUM		3	
No	W1004	W1004	F	1	3'-8"	7'-8"	1 3/4"	HM	NONE	ii	B4/B5	HM		ALUM		8	
No	W1005	W1005	C	4	13'-8 1/2"	7'-0"	1 3/4"	ALUM	None	iii	B1/B2	ALUM		ALUM		1	
No	W1006	W1006	F	1	3'-8"	7'-10"	1 3/4"	HM	NONE	i	D4/D5 SIM.	HM		ALUM		6	
No	W1007	W1007	C	4	13'-8 1/2"	7'-0"	1 3/4"	ALUM	None	iii	B1/B2	ALUM		ALUM		1	
No	W1011	W1011	C	4	13'-8 1/2"	7'-0"	1 3/4"	ALUM	None	iii	C1/C2	ALUM		ALUM		1	
No	W1013	W1013	C	4	13'-8 1/2"	7'-0"	1 3/4"	ALUM	None	iii	C1/C2	ALUM		ALUM		1	
No	W1018	W1018	F	1	3'-8"	7'-10"	1 3/4"	HM	90 min	i	D4/D5 SIM.	HM		ALUM		6	
No	W1051	W1051	F	1	3'-8"	7'-8"	1 3/4"	HM	NONE	ii	B4/B5	HM		ALUM		9	
No	W1061	W1061	F	1	3'-8"	7'-10"	1 3/4"	HM	NONE	i	D4/D5	HM		ALUM		6	
No	W1062	W1062	F	1	3'-8"	7'-10"	1 3/4"	HM	NONE	i	D4/D5	HM		ALUM		5	
No	W1063	W1063	F	1	3'-8"	7'-10"	1 3/4"	HM	NONE	i	D4/D5	HM		ALUM		6	
No	W1064	W1064	F	1	3'-8"	7'-10"	1 3/4"	HM	NONE	i	D4/D5	HM		ALUM		4	
No	W1072	W1072	F	1	4'-0"	7'-10"	1 3/4"	HM	45 min	i	B4/B5	HM		ALUM		10	
No	W1081	W1081	F	1	3'-8"	7'-10"	1 3/4"	HM	NONE	i	D4/D5	HM		ALUM		5	
No	W1114	W1114	F	1	4'-0"	7'-10"	1 3/4"	HM	45 min	i	B4/B5	HM		ALUM		10	
No	W1276	W1276	F	1	3'-8"	7'-8"	1 3/4"	HM	NONE	ii	E4/E5	HM		ALUM		5	
No	W1277	W1277	F	1	3'-8"	7'-8"	1 3/4"	HM	NONE	ii	B4/B5	HM		ALUM		8	
No	W1278	W1278	F	1	3'-8"	7'-8"	1 3/4"	HM	NONE	ii	B4/B5	HM		ALUM		8	
No	W1279	W1279	F	1	3'-8"	7'-10"	1 3/4"	HM	NONE	i	D4/D5	HM		ALUM		6	
No	W1282	W1282	F	1	3'-8"	7'-10"	1 3/4"	HM	NONE	i	D4/D5	HM		ALUM		6	
No	W1283	W1283	F	1	3'-8"	7'-8"	1 3/4"	HM	NONE	ii	E4/E5	HM		ALUM		3	
No	W1285	W1285	F	1	3'-8"	7'-10"	1 3/4"	HM	NONE	i	D4/D5	HM		ALUM		3	
01 Alternate 1																	
No	W1121	W1121	F	1	3'-8"	7'-8"	1 3/4"	HM	NONE	ii	B4/B5	HM		ALUM		9	
No	W1141	W1141	F	1	4'-0"	7'-10"	1 3/4"	HM	45 min	i	B4/B5	HM		ALUM		10	
No	W1151	W1151	F	1	3'-8"	7'-8"	1 3/4"	HM	NONE	ii	B4/B5	HM		ALUM		9	
02 Alternate 2																	
No	W1183	W1183	F	1	4'-0"	7'-10"	1 3/4"	HM	45 min	i	B4/B5	HM		ALUM		10	
No	W1201	W1201	F	1	3'-8"	7'-8"	1 3/4"	HM	NONE	ii	B4/B5	HM		ALUM		9	
No	W1266	W1266	F	1	3'-8"	7'-8"	1 3/4"	HM	NONE	ii	B4/B5	HM		ALUM		8	
No	W1267	W1267	F	1	3'-8"	7'-8"	1 3/4"	HM	NONE	ii	B4/B5	HM		ALUM		8	
No	W1268	W1268	F	1	3'-8"	7'-10"	1 3/4"	HM	NONE	i	D4/D5	HM		ALUM		6	
No	W1270	W1270	F	1	3'-8"	7'-10"	1 3/4"	HM	NONE	i	D4/D5	HM		ALUM		6	
No	W1271	W1271	F	1	3'-8"	7'-8"	1 3/4"	HM	NONE	ii	E4/E5	HM		ALUM		3	
No	W1273	W1273	F	1	3'-8"	7'-10"	1 3/4"	HM	NONE	i	D4/D5	HM		ALUM		3	
03 Alternate 3																	
No	W1231	W1231	F	1	4'-0"	7'-10"	1 3/4"	HM	45 min	i	B4/B5	HM		ALUM		10	
No	W1231B	W1231	FF	2	3'-10"	7'-8"	1 3/4"	HM	NONE	ii	B4/B5	HM		ALUM	ACS For Ramp Side Deliverys Delayed Egress	12	
No	W1232	W1232	F	1	3'-8"	7'-8"	1 3/4"	HM	NONE	ii	B4/B5	HM		ALUM		9	
No	W1251A	W1251	F	1	4'-0"	7'-10"	1 3/4"	HM	45 min	i	B4/B5	HM		ALUM	ALWAYS UNLOCKED FROM 1251	11	
05 Alternate 5																	
Yes	W1251B	W1251	F	1	3'-8"	7'-10"	1 3/4"	HM	NONE	i	B4/B5	HM		ALUM		9	

**NOTICE:**  
 SCHEDULE(S) REVISED  
 WHEN THIS AREA IS CLOUDED

**DOOR TYPES**

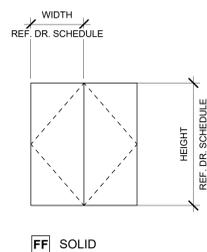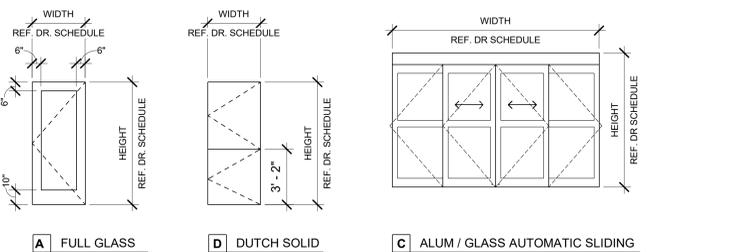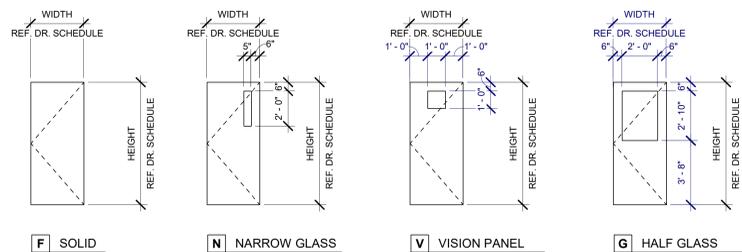

**FRAME TYPES**

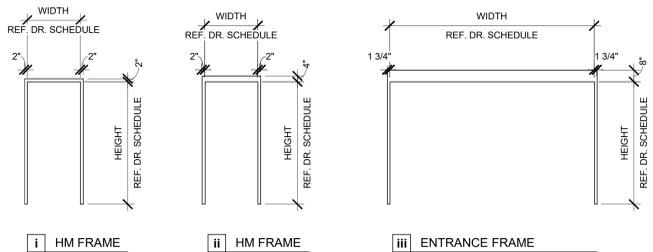

**GENERAL NOTES**

- SEE SPECIFICATION SECTION 08 71 00 FOR HARDWARE GROUPS, SECTION 08 8000 FOR GLASS TYPE OF DOORS & WINDOWS.
- REFERENCE FINISH SCHEDULE FOR ADDITIONAL DOOR & FRAME FINISH INFORMATION.
- SEE PARTITION SCHEDULE FOR DEPTH OF ALL DOORS & WINDOWS IN GYP. BOARD WALLS.
- RIGHT HAND DOOR SHALL BE ACTIVE LEAF FOR DOUBLE DOORS.
- EXTERIOR DOORS - MAXIMUM EFFORT TO OPERATE DOORS SHALL NOT EXCEED 5 LBS.
- INTERIOR DOORS - MAXIMUM EFFORT TO OPERATE DOORS SHALL NOT EXCEED 5 LBS.
- MAXIMUM EFFORT TO OPERATE DOOR SHALL NOT EXCEED 15 LBS. FOR INTERIOR AND EXTERIOR FIRE DOORS.
- TYPICAL JAMB DIMENSIONS TO ADJACENT PARTITIONS ON HINGE SIDE OF DOOR OPENINGS: 8" AT CMU & 4" AT STUD PARTITIONS U.O.N.
- ALL WOOD DOORS ARE TO BE UNDERCUT AS REQUIRED FOR FLOOR FINISHES & SPECIFICATIONS.
- WIDTH / HEIGHT DIMENSIONS ARE LEAF OPENING SIZE
- FOR DOORS IN MASONRY CONDITIONS, PROVIDE DOOR FRAME WITH 4" HEAD WIDTH FOR TOP OF FRAME.
- FINISH AT MASONRY COURSING, WHERE OCCURS. CONTRACTOR TO VERIFY IN FIELD AND COORDINATE ALL LOCATIONS.

**KEYNOTES**

NO.

**SUBMITTAL**

EXTERIOR DOORS--(FOR EACH TYPE AND SIZE INSTALLED)--PROVIDE ONE OF THE FOLLOWING (TO INCLUDE COVER PAGE AND INSTALLATION DETAILS): FLORIDA PRODUCT APPROVAL, MIAMI DADE NOA, OR (ICC-ES) NER. DOCUMENTS ARE TO BE PROVIDED BY THE SAME ROUTING METHOD AS DRAWINGS WERE SUBMITTED TO GROWTH MANAGEMENT. THIS IS TO BE SUBMITTED BEFORE A FRAMING INSPECTION. BUILDER WILL NOT BE ABLE TO SCHEDULE A FRAMING INSPECTION UNTIL A RESPONSE IS APPROVED. 2017 FBC 104.9, 107.2.1; FLORIDA ADMINISTRATIVE CODE 9B-72.005

**LEGEND**

**GLASS TYPES:**  
 1 = 1/4" 20 MIN. RATED CLEAR TEMPERED GLASS  
 2 = 1/4" CLEAR TEMPERED GLASS  
 3 = 1 7/16" 90 MIN. RATED LAMINATED GLASS (NOTE: ALL GLASS IN DOORS, SIDELITES OR TRANSOMS TO BE SAFETY GLASS.)

**MATERIALS:**  
 ALUM = ALUMINUM  
 GL = GLASS  
 SS = STAINLESS STEEL  
 WD = WOOD  
 HM = HOLLOW METAL  
 WWM = WELDED WIRE MESH  
 DET = DETENTION DOOR



**C19-2811- AP**  
**Construction**  
**of Satellite**  
**Concourse 'C'**



**MIGUEL A MARTIN**  
 FL AR-98279

SEAL

**Revisions**


No.	Date	Description
2	09-MAR-2020	ADDENDUM 002

Project No.: **MLM-19672**  
 Designed By: **MLM, MAM**  
 Drawn By: **ST, CC, DM, CB**  
 Checked By: **MAM**  
 Issue Date: **21-JAN-2020**  
 Drawing Scale: **NO SCALE**  
 Drawing Title:


**DOOR SCHEDULE**

BID DOCUMENTS


Drawing No.: **A711**

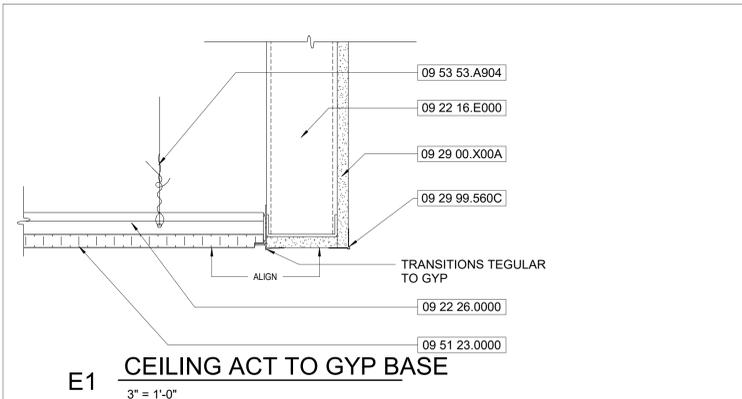


**E1 CEILING ACT TO GYP BASE**  
3" = 1'-0"

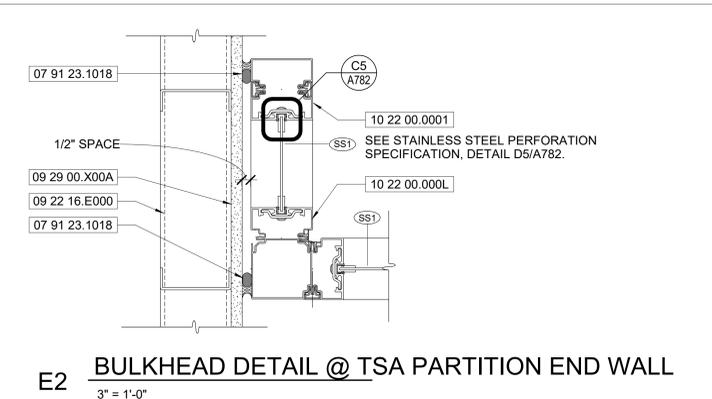


**E2 BULKHEAD DETAIL @ TSA PARTITION END WALL**  
3" = 1'-0"

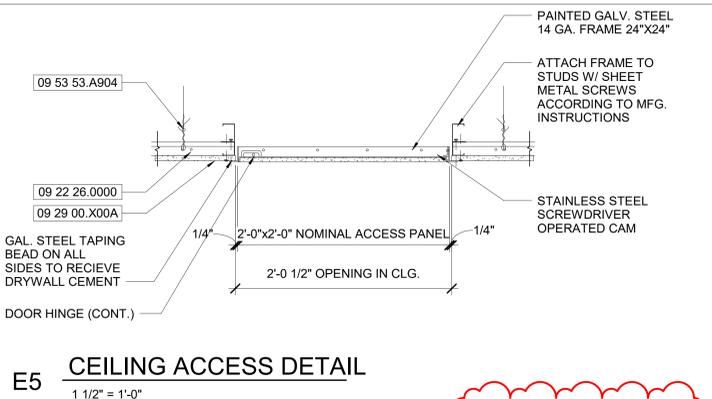


**E5 CEILING ACCESS DETAIL**  
1 1/2" = 1'-0"

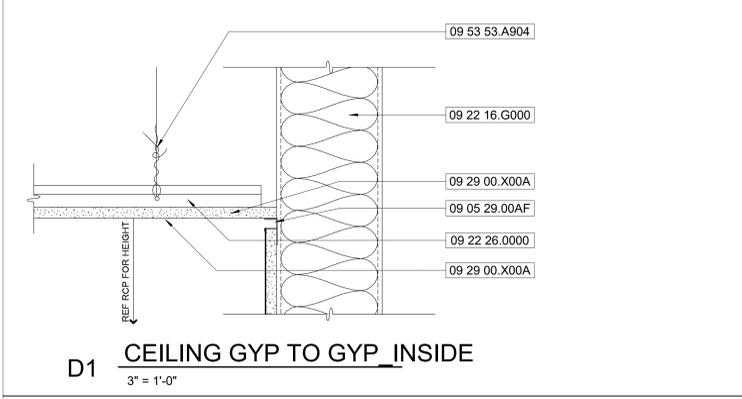


**D1 CEILING GYP TO GYP INSIDE**  
3" = 1'-0"

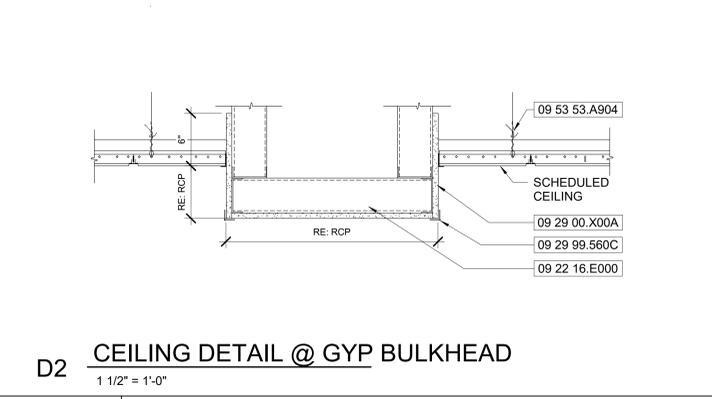


**D2 CEILING DETAIL @ GYP BULKHEAD**  
1 1/2" = 1'-0"

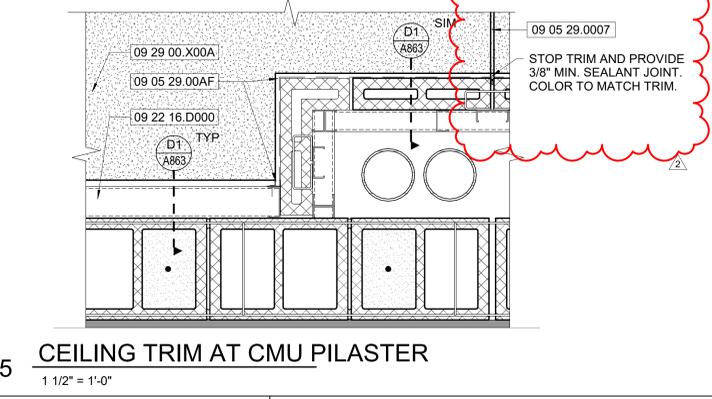


**D5 CEILING TRIM AT CMU PILASTER**  
1 1/2" = 1'-0"

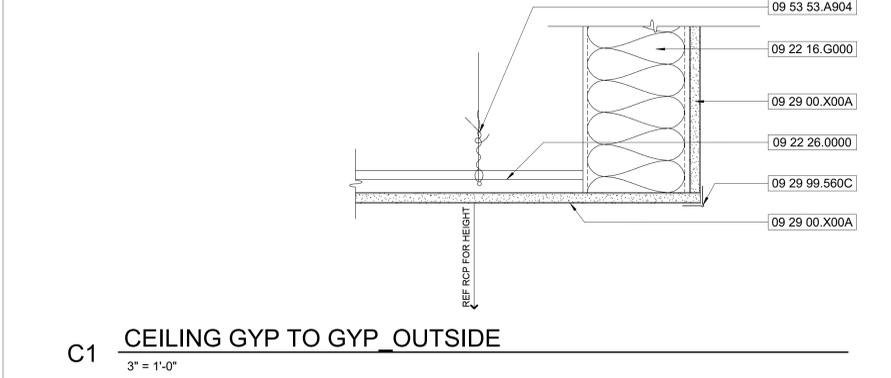


**C1 CEILING GYP TO GYP OUTSIDE**  
3" = 1'-0"

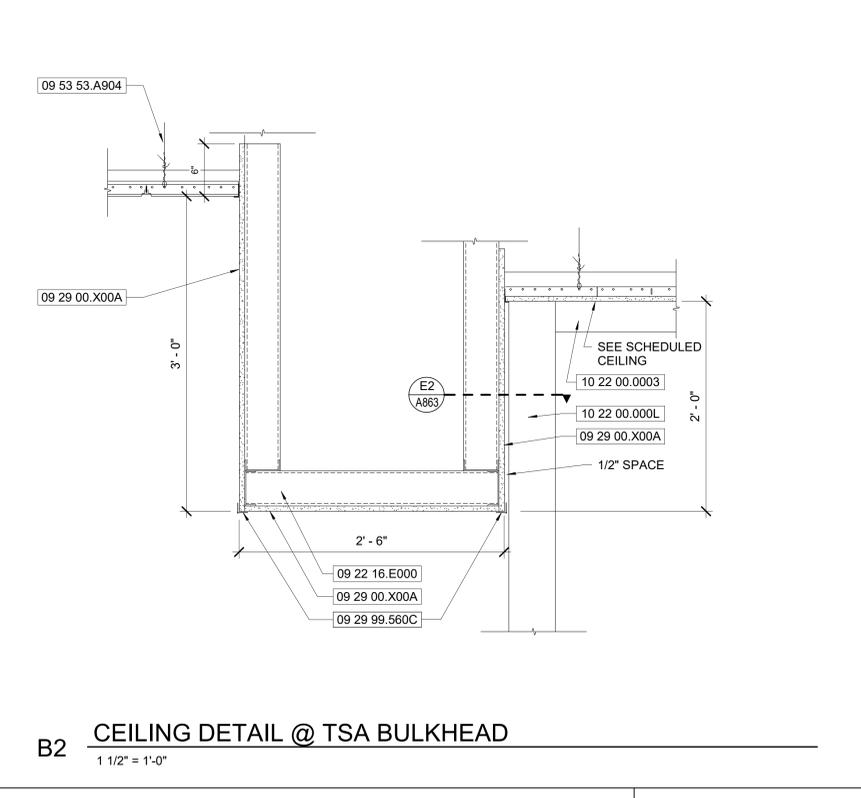


**B2 CEILING DETAIL @ TSA BULKHEAD**  
1 1/2" = 1'-0"

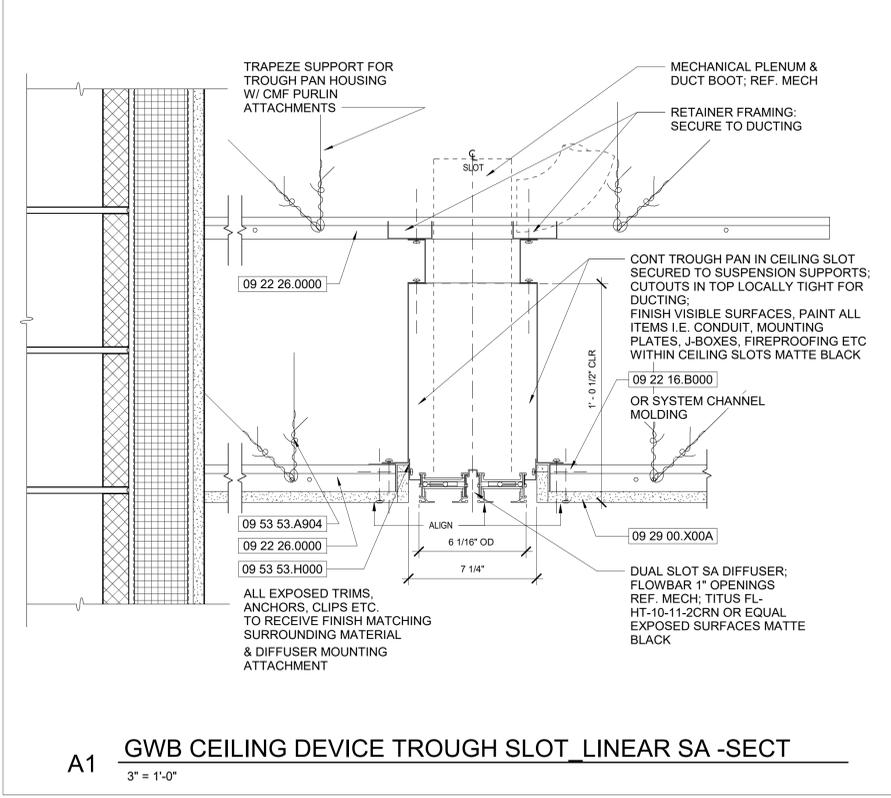

**A1 GWB CEILING DEVICE TROUGH SLOT LINEAR SA -SECT**  
3" = 1'-0"

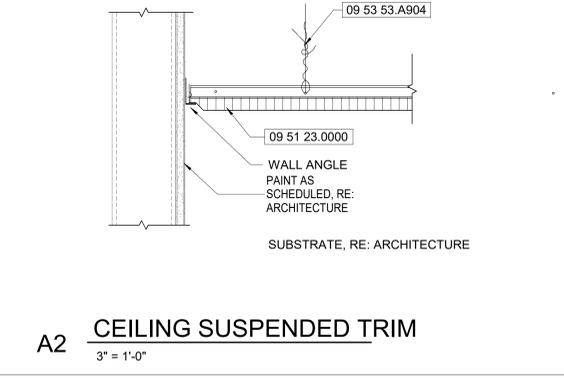

**A2 CEILING SUSPENDED TRIM**  
3" = 1'-0"

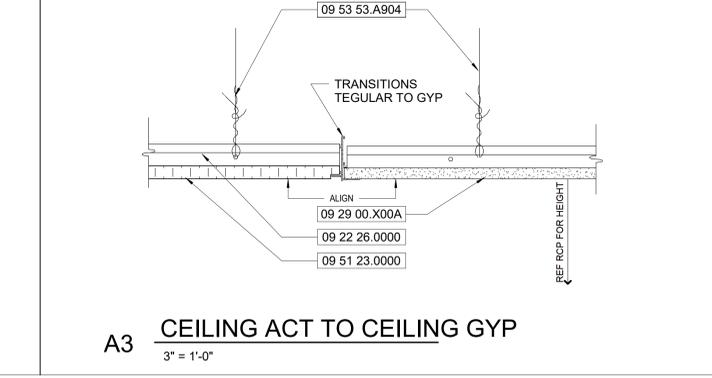

**A3 CEILING ACT TO CEILING GYP**  
3" = 1'-0"

**KEYNOTES**

- NO. 07 91 23.1018 TYP. 1/2" BACKER ROD WITH JOINT SEALANT, CONT.
- 09 05 29.00AF TYP. ALUMINUM GYPSUM BOARD 'F' REVEAL ACCESSORY.
- 09 05 29.0007 TYP. GWB ASSEMBLY CONTROL JOINT ACCESSORY.
- 09 22 16.B000 TYPICAL 2 1/2" GALV. METAL STUD FRAMING @ 24" OC UNO.
- 09 22 16.D000 TYPICAL 3 5/8" GALV. METAL STUD FRAMING @ 24" OC UNO.
- 09 22 16.E000 TYP. 4" GALV. METAL STUD FRAMING @ 24" OC UNO.
- 09 22 16.G000 TYPICAL 6" GALV. METAL STUD FRAMING @ 16" OC UNO.
- 09 22 26.0000 TYP. GYPSUM ASSEMBLY SUSPENSION SYSTEM, INSTALL PER MNFR. INSTRUCTIONS.
- 09 29 00.X00A TYPICAL 5/8" TYPE 'X' GYPSUM WALL BOARD
- 09 29 99.560C TYP. GALV. GWB ASSEMBLY CORNER BEAD TRIM ACCESSORY.
- 09 51 23.0000 TYP. ACOUSTICAL TILE CEILING SYSTEM, REF. FINISH SCHEDULES.
- 09 53 53.A904 TYPICAL 9 GAUGE GALV. METAL HANGER WIRE @ 48" O.C. EACH WAY
- 09 53 53.H000 TYPICAL SUPPORT CLIP FOR MECHANICAL DIFFUSERS/GRILLS.
- 10 22 00.000L TYP. GLAZED ALUMINUM DEMOUNTABLE WALL ASSEMBLY - 90 DEGREE CORNER EXTRUSION.
- 10 22 00.0001 TYP. GLAZED ALUMINUM DEMOUNTABLE WALL ASSEMBLY - END CAP EXTRUSION.
- 10 22 00.0003 TYP. GLAZED ALUMINUM DEMOUNTABLE WALL ASSEMBLY - HEADER EXTRUSION.



**C19-2811- AP Construction of Satellite Concourse 'C'**



**MIGUEL A MARTIN**  
FL AR-98279

SEAL

Revisions

No.	Date	Description
2	09-MAR-2020	ADDENDUM 002

Project No.: **MLM-19672**  
 Designed By: **MLM, MAM**  
 Drawn By: **ST, CC, DM, CB**  
 Checked By: **MAM**  
 Issue Date: **21-JAN-2020**  
 Drawing Scale: **As indicated**  
 Drawing Title:

**CEILING DETAILS**

BID DOCUMENTS

Drawing No.: **A863**

3/10/2020 12:16:46 PM BIM 360/Design of Satellite Concourse/VPS-MLM\_A.rvt



**C19-2811- AP**  
Construction  
of Satellite  
Concourse 'C'



**MIGUEL A MARTIN**  
FL AR-98279

Revisions

No.	Date	Description
2	09-MAR-2020	ADDENDUM 002



Project No.: **MLM-19672**  
Designed By: **MLM, MAM**  
Drawn By: **ST, CC, DM, CB**  
Checked By: **MAM**  
Issue Date: **21-JAN-2020**  
Drawing Scale: **AS NOTED**  
Drawing Title:

**METAL FABRICATION DETAILS**  
BID DOCUMENTS


Drawing No.: **A865**

**KEYNOTES**


- NO. 03 31 00.B104 TYP. 4" STRUCTURAL SLAB-ON-GRADE, SEE STRUCTURAL.
- 03 31 00.C104 TYP. 4" STRUCTURAL CAST-IN-PLACE CONCRETE WALL, SEE STRUCTURAL
- 04 01 20.1926 TYP. MASONRY REINFORCING INSPECTION OPENING @ EACH FILLED CELL, SEE STRUCTURAL
- 04 05 16.363K TYP. FILL CELL MASONRY W/ 3000 PSI GROUT.
- 04 22 00.0008 TYP. 8" NOMINAL CONCRETE MASONRY UNIT.
- 05 05 51.3300 TYP. STEEL ANGLE SUPPORT WELD CONT. @ STRINGER AND FLOOR ANCHOR
- 05 05 51.3301 2-1/2" X 3/8" VERTICAL MTL. STRINGER
- 05 05 51.3302 TYP. 1" DIA MTL. RUNGS @ 12" O.C. CONT. WELD TO EACH STRINGER
- 05 05 51.3303 TYP. 12" MIN. X 2" WIDE BENT STEEL 3/8" PLATE SUPPORT CONT. WELD TO STRINGER SO THAT MIN. CLEARANCE FROM CENTERLINE OF RUNG AND NEAREST OBSTRUCTION IS 7" U.O.N.
- 05 21 19.00K0 TYP. K SERIES OPEN WEB STEEL JOIST, SEE STRUCTURAL.
- 05 51 33.A000 STEEL ROOF ACCESS LADDER
- 05 52 13.2000 TYP. STAINLESS STEEL PIPE AND TUBE RAILING.
- 05 52 13.2012 TYP. STAINLESS STEEL PIPE AND TUBE RAILING, INFILL HORIZONTAL 1-1/4" NOM. HSS 1.660 X 0.140 PIPE.
- 05 52 13.2013 TYP. STAINLESS STEEL PIPE AND TUBE RAILING, HAND RAIL.
- 05 52 13.2017 TYP. STAINLESS STEEL PIPE AND TUBE RAILING, GUARD RAIL.
- 05 52 13.2031 TYP. STAINLESS STEEL PIPE AND TUBE RAILING, POST 1-1/2" NOM. HSS 1.900 X 0.188 PIPE @ 3'-0" OC MAX..
- 05 52 13.2053 TYP. STAINLESS STEEL PIPE AND TUBE RAILING, HANDRAIL RAIL SUPPORTS AS REQ'D.
- 05 52 13.2056 TYP. STAINLESS STEEL PIPE AND TUBE RAILING, EMBED POST MIN. OF 5".
- 07 26 16.0315 TYP. 15 MIL BELOW GRADE VAPOR BARRIER.
- 09 22 16.G000 TYPICAL 6" GALV. METAL STUD FRAMING @16" OC UNO.
- 09 22 16.G040 TYP. 16 GA. 6" GALV. METAL STUD BLOCKING.
- 09 29 00.X00A TYPICAL 5/8" TYPE 'X' GYPSUM WALL BOARD
- 09 65 19.0000 TYP. LUXARY VINYL COMPOSITION TILE, SEE SCHEDULE.
- 10 26 13.5250 TYP. 2" BRUSHED ALUMINUM WALL CORNER GUARD.
- 31 23 23.2385 TYP. COMPACTED FILL TO A MIN. OF 85% COMPACTION AS PER ASTM D1557.
- 31 31 16.1300 TYP. SPRAY TERMITE TOXICANT BARRIER.
- 32 16 23.0505 TYP. 5" BROOM FINISHED CONCRETE SIDEWALK.
- 34 01 73.0092 TYP. PRESERVE EDGE OF AIRFIELD CONSTRUCTION. COORDINATE PROTECTION OF BUILT ELEMENTS WITH ADJACENT PROJECT.

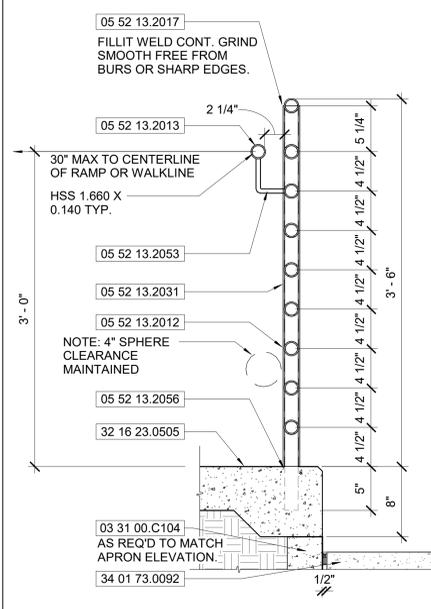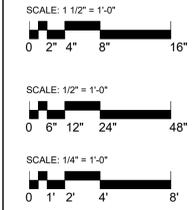


**D5 R-01 HAND & GUARDRAIL**  
1 1/2" = 1'-0"

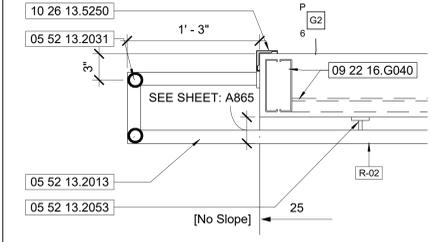


**C5 PODIUM RAIL RETURN**  
1 1/2" = 1'-0"

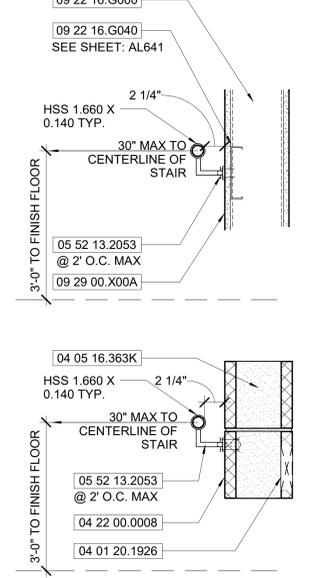


**D4 R-02 HANDRAIL**  
1 1/2" = 1'-0"

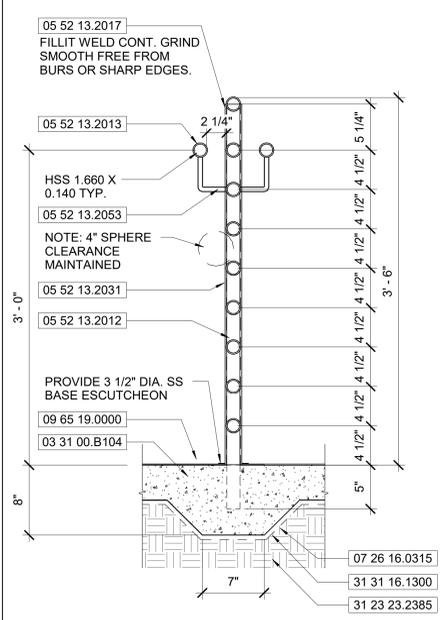


**D3 R-03 HAND & GUARDRAIL**  
1 1/2" = 1'-0"

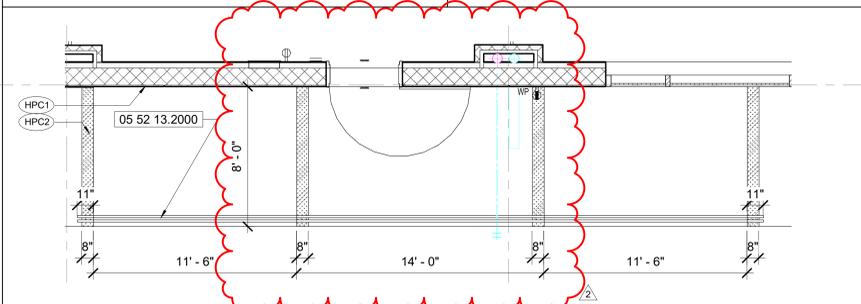


**C3 RAMP PLAN**  
1/4" = 1'-0"

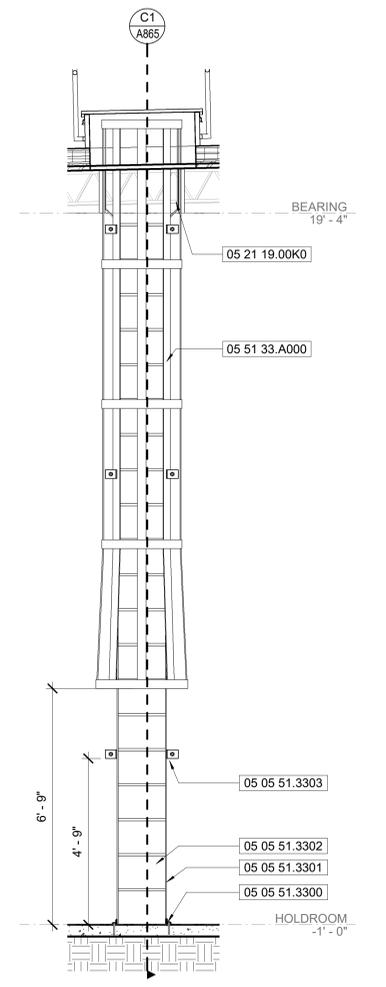

**C2 ROOF ACCESS LADDER**  
1/2" = 1'-0"

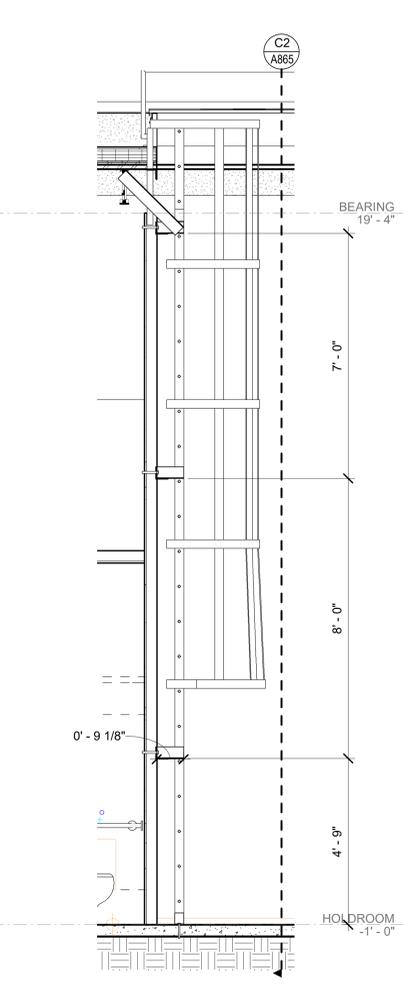

**C1 ROOF ACCESS LADDER**  
1/2" = 1'-0"

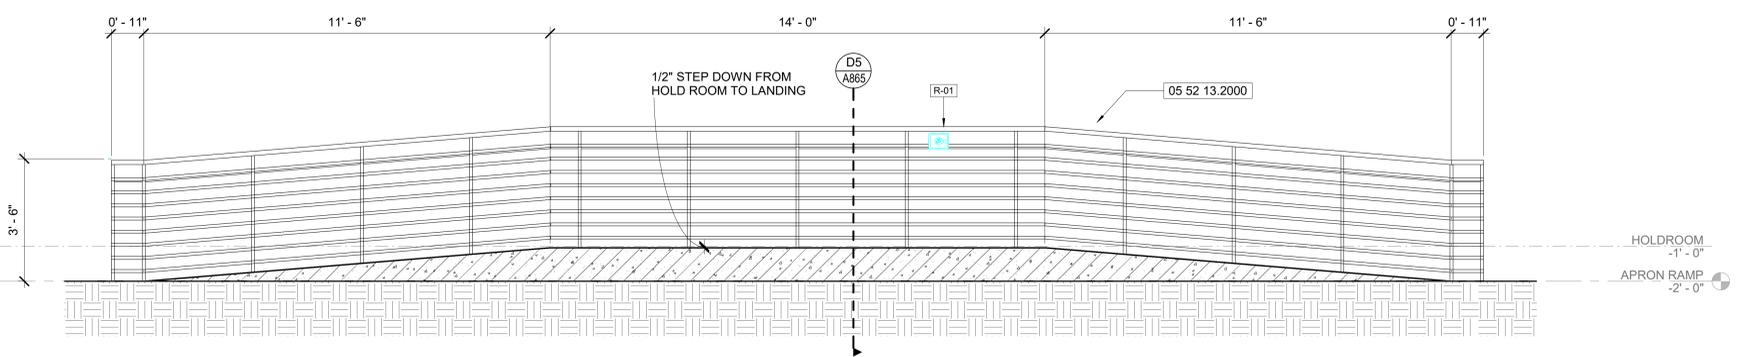

**A2 RAILING AT GATE DOOR**  
1/2" = 1'-0"

**SUBMITTAL**

CONTRACTOR SHALL PROVIDE FABRICATION DRAWINGS/ CALCULATIONS SIGNED & SEALED BY A FLORIDA REGISTERED ENGINEER IN COMPLIANCE WITH FLORIDA BUILDING CODE WITH SUPPLEMENTS FOR ALL FABRICATED STAIRS, HANDRAILS AND/OR PLATFORMS. MINIMUM 50 PLF AND 200 POUND CONCENTRATED DESIGN LOADS. DOCUMENTS ARE TO BE PROVIDED BY THE SAME ROUTING METHOD AS DRAWINGS WERE SUBMITTED TO GROWTH MANAGEMENT. THIS IS TO BE SUBMITTED BEFORE A FRAMING INSPECTION. BUILDER WILL NOT BE ABLE TO SCHEDULE A FRAMING INSPECTION UNTIL A RESPONSE IS APPROVED. 2017 FBC 104.9, 107.2.1; FLORIDA ADMINISTRATIVE CODE 9B-72.005

BIM 360/Design of Satellite Concourse/VPS-MLM\_A.rvt

3/10/2020 12:17:03 PM



C19-2811- AP Construction of Satellite Concourse 'C'



MIGUEL A MARTIN FL AR-98279


SEAL

Revisions		
No.	Date	Description
2	09-MAR-2020	ADDENDUM 002

Project No.: **MLM-19672**  
 Designed By: **MLM, MAM**  
 Drawn By: **ST, CC, DM, CB**  
 Checked By: **MAM**  
 Issue Date: **21-JAN-2020**  
 Drawing Scale: **1" = 20'-0"**  
 Drawing Title:

**OVERALL SIGNAGE FLOOR PLAN**  
 BID DOCUMENTS

Drawing No.: **AG111**

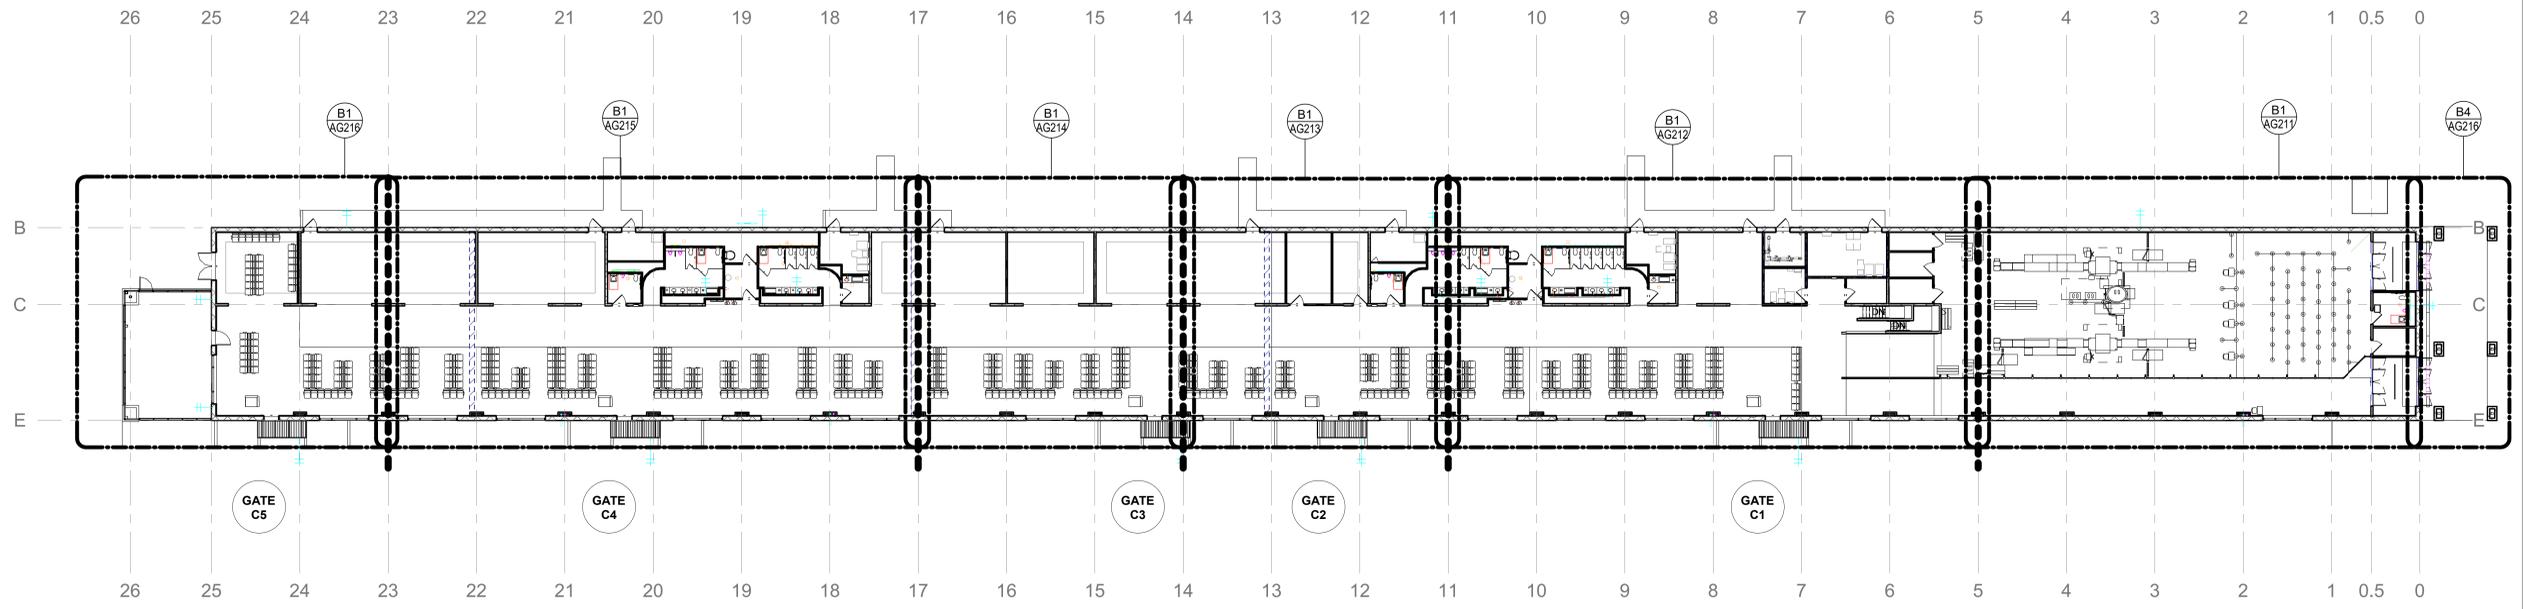

D1 OVERALL CONCOURSE SIGNAGE PLAN  
 1" = 20'-0"



**ABCDEFGHIJKLMNOPQRSTUVWXYZ0123456789**


FRUTIGER BOLD

ABCDEFGHIJKLMNOPQRSTUVWXYZ0123456789

OTTAWA REGULAR

**ABCDEFGHIJKLMNOPQRSTUVWXYZ0123456789**

OTTAWA BOLD

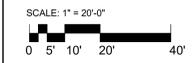

**MATERIALS**

**ELECTRICAL FABRICATION**

**FABRICATION**

- A. Aluminum:
  1. Provide durable, high-grade aluminum of alloy and temper as best suited to furnish the strength, performance, and finish required. Provide all plate, sheet, castings, hardware, and all other aluminum sign components as required. Indicate the alloys to be used on the Shop Drawings.
  2. Prior to the start of fabrication, provide extrusion manufacturer information for review by the Designer and the Owner.
  3. Aluminum extrusions shall be durable, high-grade aluminum of alloy and temper as best suited to furnish the strength, performance, and finish required. Indicate the alloys to be used on the Shop Drawings.
  4. All extrusions shall be professionally structurally engineered to provide the performance required. Provide profile review drawings and sample sections of all extrusions for review by the Designer and the Owner prior to final production.
- B. Aluminum Extrusions:
  1. Provide all standard and custom extruded aluminum sign components as required.
  2. Prior to the start of fabrication, provide extrusion manufacturer information for review by the Designer and the Owner.
  3. Aluminum extrusions shall be durable, high-grade aluminum of alloy and temper as best suited to furnish the strength, performance, and finish required. Indicate the alloys to be used on the Shop Drawings.
  4. All extrusions shall be professionally structurally engineered to provide the performance required. Provide profile review drawings and sample sections of all extrusions for review by the Designer and the Owner prior to final production.
- C. Steel:
  1. Provide durable, high-grade steel of alloy and temper as best suited to furnish the strength, performance, and finish required. Provide all steel sheets, channels, shapes, and other steel sign components as required. Indicate the alloys and types of steel to be used in the Shop Drawings. Stainless steel: Type 316
    - a. Provide hot-dip galvanized sign supports, hardware, and components as required.
    - b. Galvanize steel using the hot-dip process.
    - c. Meet all the requirements of all applicable ASTM specifications, standards, guidelines, requirements, and performance criteria for zinc (hot-dip galvanized) coatings on iron and steel sign supports, hardware, and components.
    - d. Dissimilar material: Isolate dissimilar materials from direct contact.
  2. Unfinished Threaded Fasteners:
    1. ASTM A 300 Series Grade A non-magnetic stainless steel.
    2. Vandal-resistant and tamper-resistant screws shall be stainless steel drilled spanner drive screws, or equal as reviewed and accepted by the Owner.
    3. All hardware shall be non-magnetic stainless steel, or other accepted, non-magnetic, long lasting, corrosion-resistant material.
  3. Mounting Hardware:
    1. Provide all mounting hardware and materials required to properly, safely, and securely mount the wayfinding signs and the wayfinding sign components. All hardware shall be high quality, long lasting, vandal-resistant, tamper-resistant, and corrosion-resistant.
    2. No hardware shall be visible on the wayfinding sign faces unless indicated in the Drawings.
- D. Acrylic Sheet:
  1. Provide scratch-resistant and UV-resistant clear and translucent acrylic sheets as required.
  2. Acceptable acrylic sheeting includes: Plexiglas Acrylic Sheet by Altuglas International/Arkema Inc., 2000 Market Street, Philadelphia, PA 19103, Telephone: 1-800-523-1532, or approved substitution acrylic sheeting accepted by the Designer and the Owner.
  3. 1/4" thickness, not less than 1/4" thick.
- E. Polycarbonate Sheet:
  1. Provide scratch-resistant and UV-resistant clear and translucent polycarbonate sheets as required.
  2. Acceptable polycarbonate sheeting includes: Lexan MR10 Sheet with Margard coating by Sabic Innovative Plastics, One Plastics Avenue, Pittsfield, MA 01201, Telephone: 401-861-2200, or approved substitution polycarbonate and UV-resistant polycarbonate sheeting accepted by the Owner.
  3. The thickness of material shall be determined by the Contractor, subject to review by the Designer and the Owner. Thickness not less than 1/4".
- F. Styrene Sheeting and Rigid Digital Print Media:
  1. Provide styrene sheeting suitable for use as a substrate for high-resolution graphics printed using UV-resistant inks.
  2. The thickness of material shall be determined by the Contractor, subject to review by the Designer and the Owner. Coordinate media thickness with the construction of the sign cabinets that shall hold the printed panels. Provide in thickness as recommended by the manufacturer for each location.
- G. Vinyl Graphic Films/Sheeting:
  1. Opaque Vinyl Graphic Film: 3M Scotchcal ElectroCut Film, Series 7725, opaque, or an approved substitution opaque film accepted by the Designer and the Owner.
  2. Translucent Vinyl Graphic Film: Orafol/Oraocal 8500 Translucent Graphic or an approved substitution translucent film accepted by the Designer and the Owner.
- H. Paint:
  1. Paint shall be Matthews Acrylic Polyurethane with a non-glare finish, or an approved substitution acrylic polyurethane paint formulated for use on signage. The non-glare finish of the paint shall conform to all applicable ADA requirements.
  2. Painted surfaces shall receive a compatible UV inhibiting, vandal-resistant, and graffiti-resistant protective clearcoat with a non-glare finish. The non-glare finish of the protective clearcoat shall conform to all applicable ADA guidelines and requirements. The topcoat and the clearcoat shall be supplied by the same manufacturer.
- I. Colors:
  1. All colors and finishes shall be UV-resistant and vandal-resistant.
  2. Exterior surfaces of wayfinding signs, wayfinding sign components, letters, symbols, logos, structural and mounting components, and other wayfinding sign elements shall be finished to match the colors specified. Color numbers refer to the Drawings. Match the colors listed in the finish materials and reproduction methods to be used on design Submittals and the Shop Drawings. Submit appropriate Samples for review and acceptance in each of the colors; in each of the finishes, films/sheetings, coatings, or materials; and on each of the substrates to be used.
  3. Lettering Style:
    1. The Contractor shall provide all the required fonts as indicated in the Drawings the Owner shall not provide any fonts.
    2. Letter weight (Medium, Black, etc.) and style (Roman, Italic) shall match the Drawings. Legends shall include letters, numbers, arrows, symbols, logos, graphics, borders, characters, typography, and other applications shown for wayfinding sign panels. Enlargement or reduction of artwork applications shall be done photographically or digitally. Hand cut masks or templates will not be accepted.
    3. Wayfinding sign lettering shall be executed in such a manner that all the edges and corners of the letterforms and symbols are true, clean, and photographically precise. All letterforms and symbols must be accurately reproduced.

- A. Provide all electrical engineering as required for all wayfinding signs and wayfinding sign components that require electric power. Coordinate wayfinding sign electrical and data requirements with the building electrical and data systems as referenced in documents.
- B. All electrical and lighting components provided for the wayfinding signs shall be UL listed. Identify on the Shop Drawings the materials and wiring to be used. Internally illuminated signs and graphics with video (LCD/LED) displays shall be internally wired with components required for connection to the electric power/data services.
- C. All the wayfinding signs that are connected to the electric power service, that are illuminated, or that include powered equipment or video/data displays, shall conform to all applicable electric codes including, but not limited to, the National Electrical Code and all applicable Codes, standards, guidelines, and requirements. All wayfinding signs that are connected to the electric power service, that are illuminated, or that include powered equipment or displays, shall also comply with all applicable UL, ANSI, and NEC safety and performance standards and all other applicable safety and performance standards. Where a UL standard is unavailable, the equipment supplied for the Project shall be UL listed and shall bear the UL label. All wayfinding signs that are connected to the electric power service, that are illuminated, or that include powered equipment or displays, shall be UL approved. The Contractor's and/or manufacturer's name shall not appear on the visible surfaces of the signs except as required by code.
- D. The Contractor shall route, furnish, and install all required electrical and data conduit, wiring, cables, fixtures, and requirements. The Contractor shall furnish and install all sign lighting components required for all new illuminated wayfinding signs. The Contractor shall furnish and install all LCD/LED displays and all related components for all wayfinding signs that include LCD/LED displays (Sign Types 'X').
- E. The Contractor shall determine where power and data for the sign locations can be accessed based on the Contract requirements. The Contractor shall provide the power and data to the sign locations. Run power and data conduit and wiring to the sign locations as required and make all the necessary connections. Provide the Designer and the Owner with Shop Drawings for review showing where power and data for the signs will be accessed, and how the power and data conduit will be routed from the source locations to the sign locations.
- F. All wayfinding signs and wayfinding sign components with electrical service shall be equipped with an approved external disconnect switch. The switch shall have circuits and capacity to control all primary wiring within the sign. The switch shall comply with all applicable code requirements. The location of switch shall be shown on the Shop Drawings for review by the Designer and the Owner.
- G. All wiring shall be routed through the wayfinding sign frames, the sign pendant mounting components, the sign "structure" mounting components (i.e. exterior), and/or the sign enclosures to the electrical and data components housed within, or mounted to, the wayfinding signs. There shall be no visible conduit, transformers, or raceways.
- H. Coordinate the placement and routing of conduit and placement of conduit with the electrical and data components with the wayfinding sign graphics and the wayfinding sign structures and mounting. Cutoff switches shall be consistently placed within sign type groups. Electrical components must not interfere with the functioning or appearance of the wayfinding signs.

**PAINTING AND FINISHES**

- A. All wayfinding sign finishes, coatings, and graphic reproduction methods shall be durable, high quality, UV-resistant, and vandal-resistant. Provide Product Data and information on all the finishes, coatings, and graphic reproduction methods to be used for review by the Designer, and the Owner.
- B. Finish all wayfinding sign components to protect them from corrosion with materials and finishes as appropriate for the component, its location, and its visibility. Indicate all finishes to be used in the Shop Drawings.
- C. Thoroughly clean and properly prepare all surfaces to be finished in strict accordance with the finish manufacturer's instructions. Follow the paint manufacturer's instructions to properly clean and prepare surfaces to be painted. Remove all dust, dirt, foreign materials, waxes, grease, silicones, and other contaminants from the surfaces to be finished following the manufacturer's recommendations.
- D. Properly protect all surfaces and materials from rust and corrosion at all times.
- E. Protective paint systems shall be applied in the shop as much as possible. All primer shall be applied in strict accordance with the manufacturers' published technical bulletins, procedures, and instructions. Steel material shall be spot coated with one (1) coat of primer. Surfaces that will be inaccessible for painting after assembly or installation shall be given two (2) shop coats of primer. All primers shall be appropriate for the substrate and the finish, as recommended by the manufacturer.
- F. Provisions should be made for proper handling of all stages of the priming, painting, shipping, storing, erection, and installation for protection of primed and/or painted surfaces from damage or soiling.
- G. The paint topcoat shall be applied in strict accordance with the manufacturers' published technical bulletins, procedures, and instructions.
  1. Paint shall be applied in the shop as much as possible.
  2. Apply paint topcoat over compatible primer. Apply paint topcoat to achieve the minimum dry film thickness recommended by the manufacturer to provide a high quality, durable finish and optimum corrosion protection.
- H. Apply a non-glare protective clearcoat containing UV inhibitors to external painted and silkscreen printed wayfinding sign surfaces. The non-glare protective clearcoat shall conform to all applicable ADA guidelines and requirements. Polished aluminum /satin finished aluminum shall also receive a protective gloss clearcoat. The clearcoat and the color topcoat shall be manufactured by the same company. Formulate the clearcoat to be compatible with the finishes and materials to which it will be applied and to provide maximum protection and longevity. Apply the clearcoat to achieve the finish and finish thickness and reproduction methods to be used on design Submittals and the Shop Drawings. Submit appropriate Samples for review and acceptance in each of the colors; in each of the finishes, films/sheetings, coatings, or materials; and on each of the substrates to be used.
- I. Paint surfaces and materials as required to provide proper performance, protection, function, appearance, durability, and longevity. Do not paint surfaces and materials where the paint would in any way interfere with proper assembly, installation, mounting, performance, function, appearance, durability, and longevity. Inform the Designer and the Owner of any conditions where the wayfinding sign finishes would interfere with the function or longevity of the wayfinding signs.
- J. After being brushed, ground and polished, or where subject to severe forming operations, stainless steel surfaces shall be cleaned of all extraneous material, thoroughly rinsed with clean water and dried. Lubricants used in fabrication shall be removed before work leaves the shop.
- K. Field touch up primer after assembly and installation (all interior surfaces including bolted connections nuts, and washers, etc.) one coat.
- L. Protection of metals against galvanic action shall be provided wherever dissimilar metals are in contact. All metals except galvanized steel and stainless steel, which will be in contact with concrete, mortar, plaster, or other masonry, shall also be protected. Indicate the type of protection to be provided in the Shop Drawings.

- A. All wayfinding signs shall be structurally sound and carefully fabricated using high quality materials and quality craftsmanship. All wayfinding signs and sign components shall be carefully, properly, securely, and safely assembled and attached. All wayfinding signs and sign components shall be carefully, securely, properly, and safely mounted and installed.
- B. Provide all the required labor, site inspection, testing, professional engineering, parts, hardware, materials, and components required to completely, properly, safely, and securely fabricate and install all the wayfinding signs, all the wayfinding sign structures, and all the wayfinding sign components. Provide all the internal and external framing and components required to safety, securely, and properly support the signs, the sign faces, and any other components that are mounted to or in the wayfinding signs.
- C. All wayfinding signs shall be fabricated to have a neat and clean appearance. All wayfinding signs shall be rigid and structurally sound. Wayfinding sign materials, design, sizes, and thickness shall be as shown on the Shop Drawings and herein specified. Methods of fabrication, assembly, erection, mounting, and installation, however, unless otherwise specified, shall be at the sole discretion of the Contractor, whose responsibility it shall be to guarantee satisfactory performance as herein specified.
- D. All wayfinding sign components including, but not limited to, wayfinding sign frames, wayfinding sign structures, wayfinding sign cabinets, wayfinding sign hardware, wayfinding sign supports, and the structures supporting the wayfinding signs, shall be professionally engineered prior to fabrication.
- E. Size the wayfinding sign frames and wayfinding sign face panels to allow for expansion and contraction of the wayfinding signs and wayfinding sign components without causing the signs to become damaged or the sign faces to become warped, cracked, or otherwise distorted.
- F. Provide mounting hardware and mounting components that are compatible with the conditions at each of the installation locations. The Contractor shall provide sign and sealed Shop Drawings for mounting hardware and other structural components for the sign.
  1. Prior to fabrication, verify the as-built conditions at each mounting location on site.
  2. Determine the type of mounting hardware and components required for each condition and each location.
  3. Indicate the mounting hardware and components in the Shop Drawings.
  4. All mounting hardware and mounting components shall be properly sized, compatible with the wayfinding signs, and the structures supporting the wayfinding signs, and shall provide the proper strength and durability.
  5. Use materials and hardware that will provide long service life and will properly, securely, and safely support the wayfinding signs. All mounting components and mounting hardware shall be of cut-off quality, high quality, UV-resistant, tamper-resistant, and corrosion-resistant components.
  6. Provide all the necessary straps, clips, brackets, and all other hardware and components required to safely, securely, and properly mount the wayfinding signs. There shall be no sharp projections or edges on either the wayfinding signs or the mounting hardware and components.
- G. All artwork shall be enlarged digitally to match the contract documents as shown in the Drawings and Message Schedule. Provide all file preparation required. Assemble legends, prepare digital files, and prepare art.
- H. Provide access to allow servicing of components housed within the wayfinding signs, sign cabinets, and wayfinding sign structures and/or to allow structural connections, electrical and data connections, or access to mounting hardware. The finishes of the removable wayfinding sign surfaces shall match the surrounding areas, unless otherwise noted. Service covers, doors, access panels, and other openings in the wayfinding signs, wayfinding sign cabinets, and wayfinding sign structures shall be weather-tight and gasketed to prevent water, dust, or dirt from entering the wayfinding signs, wayfinding sign cabinets, or wayfinding sign structures. Unless otherwise noted, provide hold open devices for service covers, doors, access panels, and other openings in the wayfinding signs that are adequate for safety and ease of maintenance. Hold open devices shall be released accidentally, or by the action of the wind, and shall not interfere with the display when the service covers, doors, access panels, and other openings in the wayfinding signs are closed. Service covers, doors, access panels, and other openings in the wayfinding signs, wayfinding sign cabinets, or wayfinding sign structures shall be held open by means of sealed tamper-resistant and vandal-resistant hardware or locks. Indicate the exact hardware to be used in the Shop Drawings.
- I. Wayfinding sign faces and edges shall be flat, rigid, smooth, and free of defects and "oil-canning." Edges and corners shall be precise, smooth, true, and free of saw marks, chips, burrs, discoloration, irregularities, and any other defects. Corners shall be mitered. Faces and returns shall be flat, precise, smooth, true, and free of saw marks, chips, burrs, discoloration, irregularities, and any other defects. There shall be no sharp or rough edges, no sharp or rough corners, and no sharp or rough projections anywhere on the wayfinding signs. Seams shall have hairline contact. Wayfinding sign faces shall be of sufficient thickness that hardware or materials mounted to or attached to the backs of the sign faces shall not distort or discolor the fronts of the sign faces or otherwise detract from the smoothness and the appearance of the sign faces in any way. Joints shall be undetectable and completely and permanently sealed. There shall be no visible hardware on any sign faces unless indicated in the Drawings. Any visible hardware shall be finished to match the surrounding material.
- J. Provide ventilation of wayfinding sign housings, structures, and cabinets as required to prevent the wayfinding signs from becoming damaged from heat, to prevent internal components from overheating, to prevent any electronic components or displays mounted within the signs from overheating, and to prevent wayfinding sign faces from warping or otherwise becoming damaged from heat, while maintaining a proper weather seal. Wayfinding signs and sign cabinets with light leaks will not be accepted.
- K. Place weep holes and openings for ventilation and to allow water accumulated through condensation to drain. Place weep holes and vents so as to not interfere with the display of the graphics and to be as unobtrusive as possible. Indicate the location of weep holes and vents in the Shop Drawings. Provide screening over all weep holes and vents to prevent animals and insects from entering the wayfinding sign structures and wayfinding sign cabinets. Fabricate the weep holes and vents so that the interiors of the wayfinding sign structures and wayfinding sign cabinets are sign cabinets are not visible through the holes and vents and so that no light is visible through the holes and vents.

- L. Internally illuminated graphics shall be completely, evenly, and adequately lit without thin spots, shadows, halos, or hot spots. Opaque sign faces and components must be completely and evenly opaque without thin spots, shadows, halos, or light leaks.
- M. Vinyl Graphic Films and Sheet for Letter Sign Types:
  1. Opaque and translucent vinyl graphic films and sheeting shall be handled and applied in accordance with the material manufacturer's instructions.
  2. Graphics produced using opaque and translucent vinyl graphic films and sheeting shall be produced in accordance with the material manufacturer's instructions.
  3. Cut-out letterforms, symbols, and logos shall be cut out so that their proportions and details are accurately and precisely reproduced. Vinyl graphic films and sheeting applied to wayfinding sign faces and panels shall be neatly trimmed and properly placed and aligned. The edges of the vinyl graphic films and sheeting shall be smooth and free of any tears, irregularities, and defects.
  4. Properly clean and prepare substrates to receive opaque, reflective, and translucent vinyl graphic films and sheeting.
  5. All opaque and translucent vinyl graphic films and sheeting shall be carefully installed so that the films and sheeting are properly and completely adhered. There shall be no loose edges or gaps between the applied materials and the substrates to which they are adhering and precisely reproduced. Vinyl graphic films and sheeting shall be installed so that they are completely smooth, flat, even, and without any surface irregularities, wrinkles, air bubbles, and free from any trapped dirt or dust.
- N. Hanger Tubes
  1. Provide for all signs, new hanger tubes for pendant mounted overhead wayfinding signs. Provide all hardware, patching and repair required to safely, securely, and properly mount the new tubes in their correct positions. The new hanger tubes shall conceal the pendant mounting components and any electrical and data conduit. The new hanger tubes with the escutcheon component shall also conceal holes drilled into the ceiling for the mounting components. If the existing holes drilled into the ceiling are larger than the new hanger tubes, provide repairs as required to conceal the holes. Verify the correct length for each new hanger tube on site. Installed hanger tubes shall be plumb and straight. Coordinate all new hanger tubes with the sign mounting components and the top cap fabrication.
- O. Internally Illuminated Wayfinding Sign Cabinets:
  1. New internally illuminated wayfinding sign cabinets shall be fabricated from aluminum. Thickness of the aluminum shall be adequate for the size of sign cabinet. Finishes shall be as shown in the Drawings.
  2. The internal illumination shall be provided by concealed white LED lamps. The Contractor shall determine the lamp circuitry, quantity, wattage, and spacing required to provide even and adequate illumination of the entire sign face. The color of the new LED lamps shall be the color of the lamps as specified (6500K natural white). Provide all the required hardware, fittings, fixtures, raceways, and all other components and materials required to properly, safely, and securely install the LED lamps and all the related components.
  3. The inside surfaces of the sign cabinets shall be finished with a reflective white coating, specifically formulated for use in internally illuminated sign cabinets, such as the following: Spray-Grip White, or an approved substitution reflective coating.
  4. The wayfinding sign cabinets shall be fabricated so that their corners shall be smooth, free from defects, burrs, and discoloration. Faces, edges, and returns shall be flat, smooth, and free from irregularities and defects. Joints shall be undetectable and permanently sealed. The wayfinding sign cabinets shall provide bright, even lighting across the entire sign face.
  5. Provide durable, corrosion-resistant internal framing for the wayfinding sign cabinets as required for the cabinets to be rigid and structurally sound and to safely, securely, and properly support the sign faces and any other components. Provide all internal wayfinding sign cabinets. Provide all internal framing as required for the cabinets to be safely, securely, and permanently mounted.
  6. Internally illuminated wayfinding sign cabinets shall be safely, securely and permanently mounted. Provide all the appropriate mounting components, hardware, materials, and accessories. There shall be no visible hardware, raceways, or conduit.
  7. Provide hanger tubes for pendant mounted overhead wayfinding signs. The hanger tubes shall conceal the pendant mounting components and any electrical and data conduit. The hanger tubes shall also conceal holes drilled into the ceiling for the mounting components. Verify the correct length for each hanger tube on site. Installed hanger tubes shall be plumb and straight. Provide all hardware required to safely, securely, and properly mount the hanger tubes with the sign mounting components and the top cap fabrication.
- P. Provide wayfinding signs and wayfinding sign assemblies that are designed, tested, and installed to withstand positive and negative wind loads appropriate for the install locations, and approved by a qualified professional licensed structural engineer. Furnish engineering calculations to show that maximum stresses and deflections of the wayfinding signage and the wayfinding signage support systems do not exceed specified and permitted performance requirements under full design loading. Calculations shall be prepared, signed, and sealed by a qualified professional structural engineer, licensed in the State of Florida and submitted with the Shop Drawings.
- Q. Insofar as practicable, fitting and assembly of the Work shall be done in the shop. Work that cannot be permanently shop-assembled shall be completely assembled, marked, and disassembled before shipment, to insure proper assembly in the field. Unless otherwise noted, field joints in the face of wayfinding signs shall not be allowed. The Contractor shall coordinate sizes of finished assemblies with access limitations to final locations.
- R. Steel and aluminum shall be well formed to shape and size. Fabrication shall leave clean, true lines and surfaces. Carefully match exposed work to produce continuity of line and design. Joints and seams, unless otherwise shown or specified, shall be accurately fitted and rigidly secured with hairline contact.

- S. Welding shall be in accordance with appropriate recommendations of the American Welding Society, and shall be done with electrodes and methods recommended by the manufacturers of the alloys being welded. Type, size, and spacing of welds shall be as shown in the Shop Drawings. Welds behind finished surfaces shall be so done as to minimize distortion and discoloration on the finished side. Weld spatter and welding oxides on finished surfaces shall be removed by descaling or grinding. Unless otherwise shown or specified, all weld beads on exposed polished surfaces shall be ground and polished to match and blend with the finish on the adjacent parent metal. Remove paint from existing steel members at contact areas and on surfaces within two inches (2") of field welds, in order to attach signage steel supports. At attachments to exposed steel, grind exposed field welded joints smooth and restore to match factory finishes. Welding shall be executed by experienced, certified operators with proper equipment and training and who have been qualified previously by tests as prescribed in the American Welding Society's "Standard Qualification Procedure" to perform the Work required.

**SOURCE AND MANUFACTURES**

- A. Source Quality Control:
  1. Obtain primary materials from a single manufacturer.
  2. Provide secondary materials only as recommended by the manufacturer of the primary materials.
  3. Do not change source or brands of materials during fabrication.
- B. Signs shall be designed and manufactured by the following or entity that is approved by Architect and Owner following substitution request procedures. Approvals must be in writing:
  - Himes Signs Corporation  
PO BOX 5324 - #4 Commerce Park  
Destin, FL 32540  
850-837-1159  
Johnny Himes  
Architectural Graphics, Inc.  
2655 International Parkway  
Virginia Beach, VA 23452  
800-877-7868  
757-427-1900 x 270  
Mr. Richard Summitton
  - Media One Graphix  
150 National Place #100  
Longwood, FL 32750  
877-972-7844  
Mr. Rick Ream
  - APCO Signs  
10012 N. Dale Mabry Hwy.  
Suite 217  
Tampa, FL 33618  
813.960.1672  
Ms. Gina Letzo
  - A.C. Signs  
10201 Rocket Ct.  
Orlando, FL 32824  
407.857.5564  
Mr. Rob Jarvis
  - Universal Sign Systems  
5001 Falcon View SE  
Grand Rapids, MI 49512  
616.554.9999  
Mr. Nate Zevnerbergen
- Other manufacturers may be considered if they meet Quality Assurance Criteria and are subject to Product substitution review per Section 26 0508 by the Architect/Engineer. Substitutions must be requested in writing, along with documentation per Section 01 2513 Product Substitutions.



C19-2811- AP  
Construction  
of Satellite  
Concourse 'C'



MIGUEL A MARTIN  
FL AR-98279

SEAL

Revisions		
No.	Date	Description
2	09-MAR-2020	ADDENDUM 002

Project No.: MLM-19672  
Designed By: MAM  
Drawn By: MAM  
Checked By: MAM  
Issue Date: 09-MAR-2020  
Drawing Scale: NO SCALE  
Drawing Title:

**SIGN TYPE  
GENERAL  
NOTES**  
BID DOCUMENTS

AG112



C19-2811- AP  
Construction  
of Satellite  
Concourse 'C'



MIGUEL A MARTIN  
FL AR-98279

SEAL

Revisions


No.	Date	Description
2	09-MAR-2020	ADDENDUM 002

Project No.: **MLM-19672**  
Designed By: **MLM, MAM**  
Drawn By: **ST, CC, DM, CB**  
Checked By: **MAM**  
Issue Date: **21-JAN-2020**  
Drawing Scale: **As indicated**  
Drawing Title:


**SIGN TYPE  
ELEVATIONS**

BID DOCUMENTS


Drawing No.:  
**AG512**

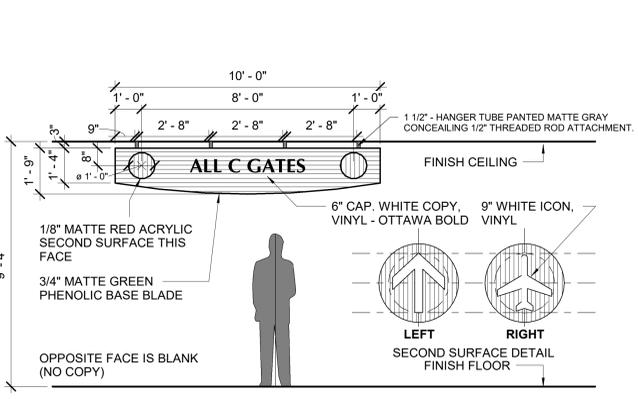


D1 [D1] DOUBLE FACED CEILING MOUNT  
3/8" = 1'-0"

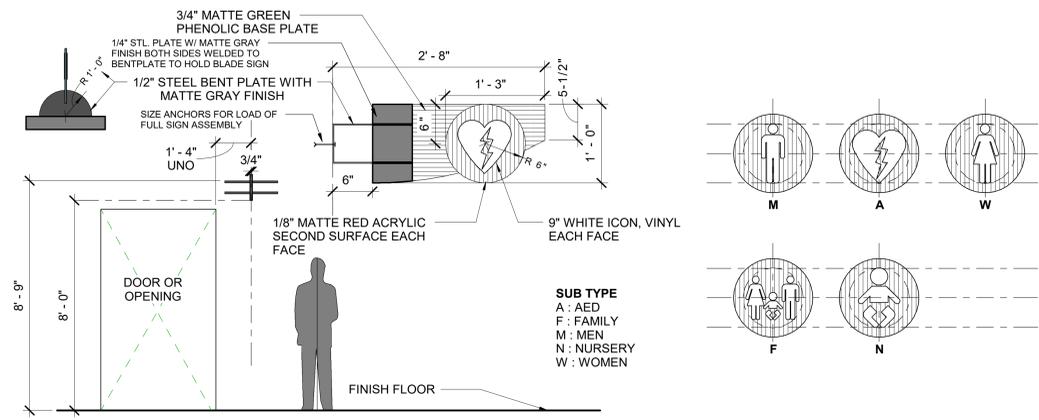


D3 [B2-X] WALL PROJECTION SMALL FORMAT  
3/8" = 1'-0"

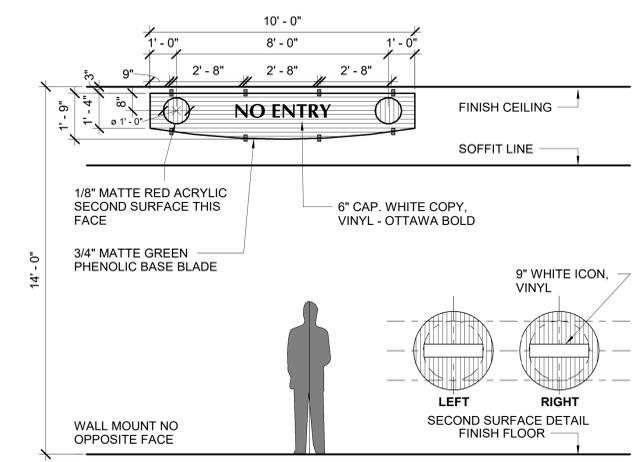


B1 [D3] SINGLE FACED WALL MOUNT  
3/8" = 1'-0"

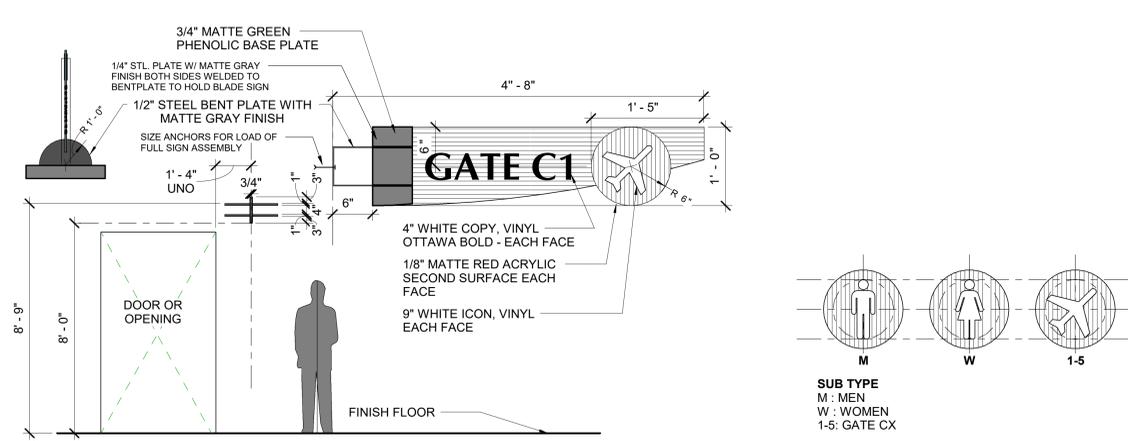

B3 [B-X] WALL PROJECTION  
3/8" = 1'-0"

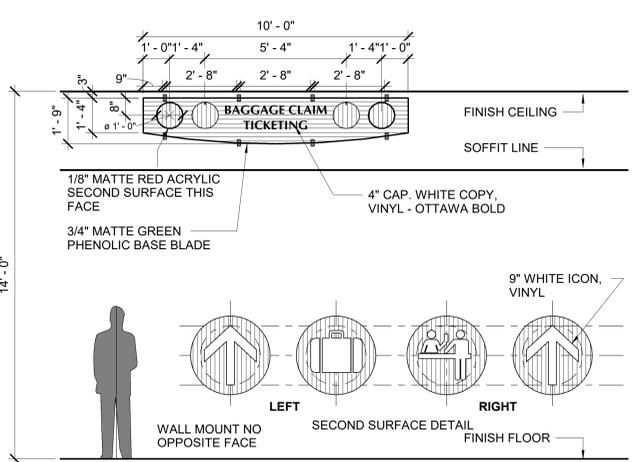

A1 [D4] SINGLE FACED WALL MOUNT  
3/8" = 1'-0"

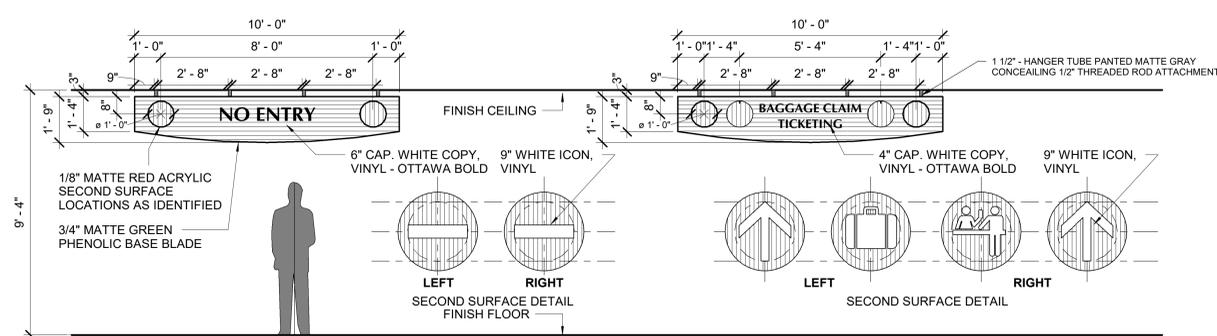

A3 [D2] DOUBLE FACED CEILING MOUNT  
3/8" = 1'-0"

**NOTES**

- REFER TO A441 FOR PARTITION TYPES
- FOR DOOR TYPES AND SCHEDULES REFER TO SHEET SERIES A711
- REFER TO ELECTRICAL, TELECOM AV, AND SIGNAGE DRAWINGS FOR OUTLET INFORMATION.
- REFER TO A SERIES SHEETS FOR DIMENSIONS
- AREA DESIGNATED FOR FUTURE WORK (NIC), CONTRACTOR SHALL KEEP THIS AREA CLEAR OF ANY BUILT ELEMENTS ABOVE AND/OR BELOW GROUND UNLESS OTHERWISE NOTED WITHIN THE SCOPE OF THIS PROJECT.
- ALL GRADE II BRAILLE IS PRESENTED FOR GRAPHIC REPRESENTATION. CONTRACTOR TO COORDINATE WITH FABRICATOR THAT ACTUAL BRAILLE PRODUCED TRANSLATES THE COPY PROVIDED.
- MESSAGES ILLUSTRATED IN DRAWINGS ARE NOT ACTUAL MESSAGES BUT FOR LAYOUT PURPOSES ONLY. SEE MESSAGE SCHEDULE FOR SPECIFIC MESSAGES. NOTE THAT BID ISSUE OF THE MESSAGE SCHEDULE IS DRAFT LEVEL AND IS TO BE UPDATED BY FABRICATOR THROUGHOUT PROJECT CONSTRUCTION SUBMITTAL PROCESS.
- SIGN LOCATION PLAN SYMBOLS INDICATE GENERAL SIGN LOCATIONS. THEY ARE NOT REPRESENTATIVE OF ACTUAL SIGN SIZES OR OR LOCATIONS. SEE MOUNTING DETAILS FOR MOUNTING LOCATION INFORMATION. CONDUCT PRE-CONSTRUCTION MEETING IN FIELD WITH AIRPORT AND ARCHITECT TO ESTABLISH PROTOTYPICAL LOCATIONS AND HEIGHTS FOR EACH SIGN TYPE.
- FABRICATOR TO FIELD VERIFY ALL EXISTING CONDITIONS AND THEIR IMPACT ON FINAL SIGN DIMENSIONS PRIOR TO FABRICATION.
- SUBSTITUTE TYPEFACES, ARROWS OR SYMBOLS WILL NOT BE ACCEPTED. ALL SYMBOLS TO BE STANDARD F.A.A., A.S.A., DOT, ANSI, ADA SYMBOLS. IF NECESSARY, CONTACT ARCHITECT FOR INFORMATION ON AVAILABILITY.
- ALL FASTENERS TO BE CONCEALED AND VANDAL RESISTANT UNLESS OTHERWISE NOTED.
- FABRICATOR TO BE RESPONSIBLE FOR PULLING ALL PERMITS AND COORDINATING ALL INSPECTIONS REQUIRED IN CONNECTION WITH THE WORK.
- SIGN LOCATION SYMBOLS IN PLAN ASSIGNED SHOULD BE CROSS REFERENCED TO ELEVATION FOR INDICATION THAT SIGN IS DOUBLE FACED. PROJECTIONS SIGNS ARE ALSO DOUBLE FACED.
- FABRICATOR SHALL BE RESPONSIBLE FOR PREPARATION OF ITS SUBMITTALS AND PULLING OF ALL NECESSARY PERMITS AND VARIANCES, (IF APPLICABLE), INCLUDING SUBMITTALS FOR OTHER RELATED REVIEW COMMITTEES FOR THIS PROJECT'S JURISDICTION. TASKS ALSO INCLUDE COORDINATION OF ALL INSPECTIONS REQUIRED IN CONNECTION WITH THE WORK.
- FABRICATOR SHALL BE RESPONSIBLE FOR LAYOUT AND PRODUCTION OF FULL SIZE TEMPLATES FOR ALL DIMENSIONAL LETTERS AND OTHER SPECIALIZED FORMATS. THESE ALSO REQUIRE THE FIELD REVIEW BY OWNER, ARCHITECT AND OTHER DESIGN PROFESSIONALS.
- FOR SIGNS IN WHICH THE MOUNTING LOCATION IS REQUIRED TO BE ON GLASS, FABRICATOR SHALL PROVIDE VINYL SHEET PRECISION MEASURED TO SIZE OF SIGN AND APPLIED TO REVERSE SIDE OF GLASS. THE VINYL COLOR SHALL MATCH THE COLOR OF THE SIGN. THE SIGN AND ITS DOUBLE FACED TAPE ARE TO BE APPLIED TO THE VIEWING SIDE OF GLASS. THE "BACKER" VINYL SHALL BE OPTICALLY POSITIONED, SO NO "BACKER" VINYL IS SEEN.


INDICATES SIGN TYPE REF. ELEVATIONS AG51X SERIES

**COLOR LEGEND**

- ALUMINUM ANODIZED
- MATTHEWS "RED" - [7A-2A] PMS-179C
- BRISTOL "BLUE" - [75A-4A] PMS-5483C
- CASTLE KEEP "GREEN" - [62C-4D] PMS-7475C
- WHITE
- WHITE TEXT U.O.N.

**ELEVATION INDEX**

- D1 B2-X
- D3 B-X
- D4 D2

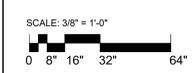

BIM 380/Design of Satellite Concourse/VPS-MLM\_A.rvt

3/10/2020 12:17:47 PM



C19-2811- AP  
Construction  
of Satellite  
Concourse 'C'



MIGUEL A MARTIN  
FL AR-98279

SEAL

Revisions


No.	Date	Description
2	09-MAR-2020	ADDENDUM 002

Project No.: **MLM-19672**  
Designed By: **MLM, MAM**  
Drawn By: **ST, CC, DM, CB**  
Checked By: **MAM**  
Issue Date: **21-JAN-2020**  
Drawing Scale: **As indicated**  
Drawing Title:


**SIGN TYPE  
ELEVATIONS**

BID DOCUMENTS


Drawing No.:  
**AG513**

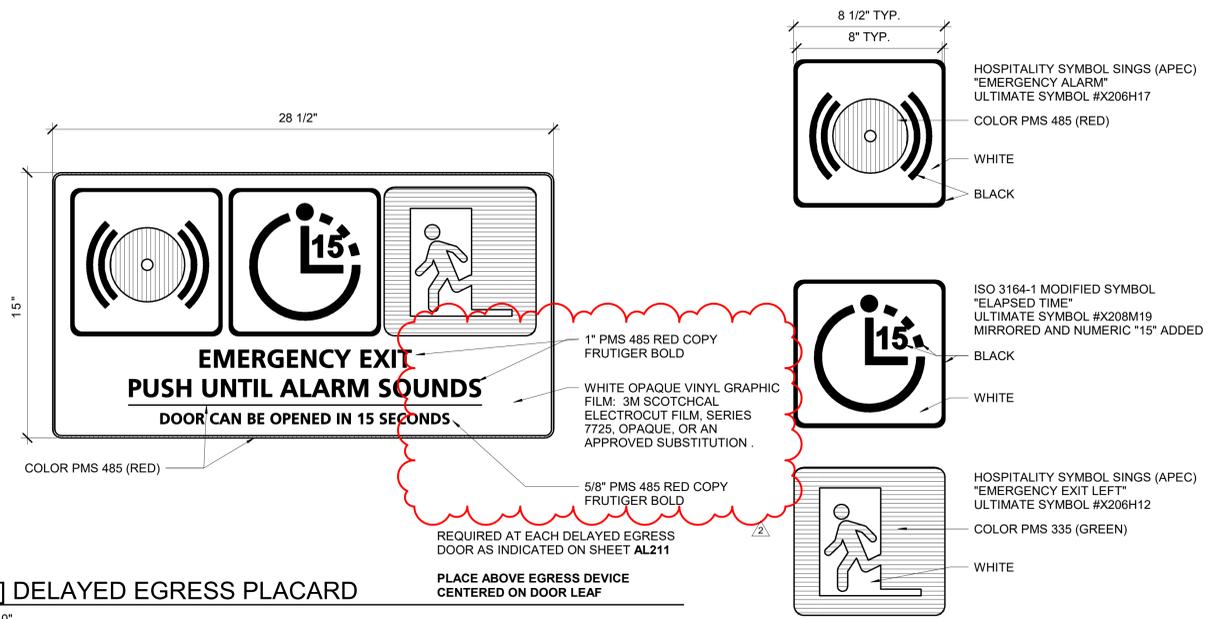


D3 [ZD] DELAYED EGRESS PLACARD  
3\"/>

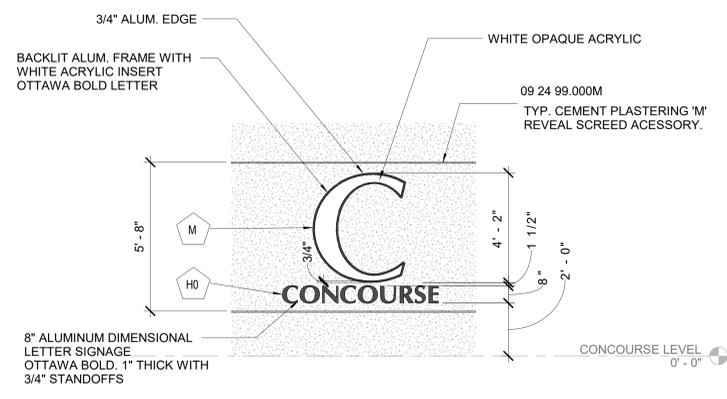


D1 [M][HO] CONCOURSE ENTRY SIGN  
3\"/>

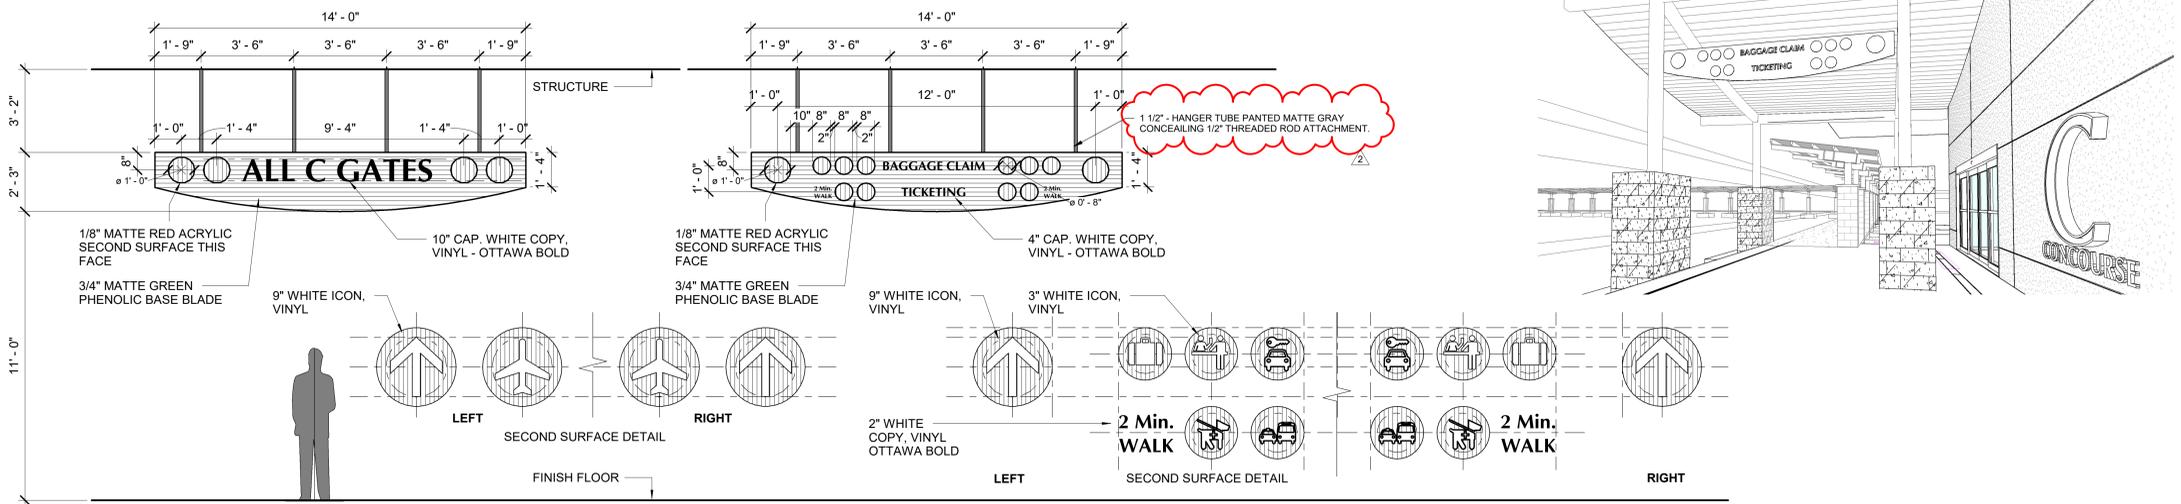


B1 [D14] DOUBLE FACED BLADE  
3\"/>

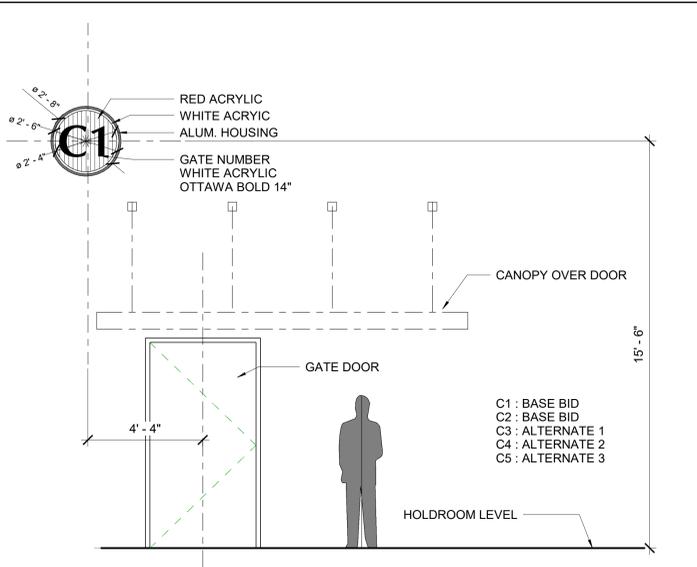

A1 [K1] EXTERIOR GATE IDEN.  
3\"/>

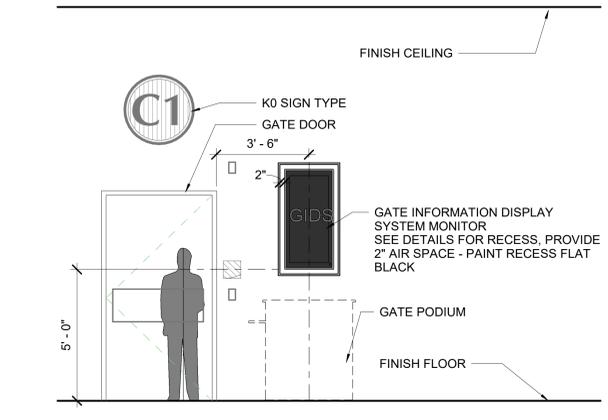

A2 [X1] GATE INFO. DISPLAY  
3\"/>

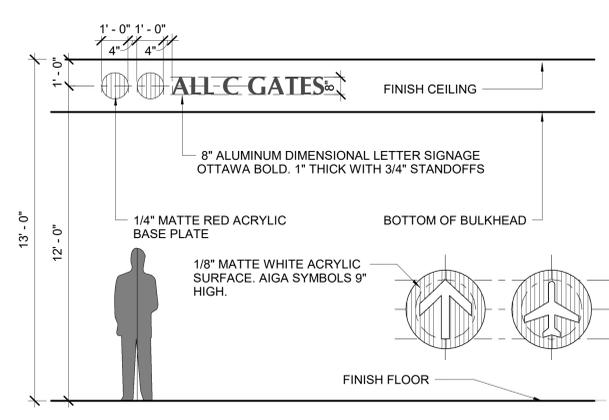

A4 [H1] DIM. LETTERS  
3\"/>

**NOTES**

- REFER TO A441 FOR PARTITION TYPES
- FOR DOOR TYPES AND SCHEDULES REFER TO SHEET SERIES A711
- REFER TO ELECTRICAL, TELECOM, AV, AND SIGNAGE DRAWINGS FOR OUTLET INFORMATION.
- REFER TO A SERIES SHEETS FOR DIMENSIONS
- AREA DESIGNATED FOR FUTURE WORK (NIC), CONTRACTOR SHALL KEEP THIS AREA CLEAR OF ANY BUILT ELEMENTS ABOVE AND/OR BELOW GROUND UNLESS OTHERWISE NOTED WITHIN THE SCOPE OF THIS PROJECT.
- ALL GRADE II BRAILLE IS PRESENTED FOR GRAPHIC REPRESENTATION. CONTRACTOR TO COORDINATE WITH FABRICATOR THAT ACTUAL BRAILLE PRODUCED TRANSLATES THE COPY PROVIDED.
- MESSAGES ILLUSTRATED IN DRAWINGS ARE NOT ACTUAL MESSAGES BUT FOR LAYOUT PURPOSES ONLY. SEE MESSAGE SCHEDULE FOR SPECIFIC MESSAGES. NOTE THAT BID ISSUE OF THE MESSAGE SCHEDULE IS DRAFT LEVEL AND IS TO BE UPDATED BY FABRICATOR THROUGHOUT PROJECT CONSTRUCTION SUBMITTAL PROCESS.
- SIGN LOCATION PLAN SYMBOLS INDICATE GENERAL SIGN LOCATIONS. THEY ARE NOT REPRESENTATIVE OF ACTUAL SIGN SIZES OR OR LOCATIONS. SEE MOUNTING DETAILS FOR MOUNTING LOCATION INFORMATION. CONDUCT PRE-CONSTRUCTION MEETING IN FIELD WITH AIRPORT, AND ARCHITECT TO ESTABLISH PROTOTYPICAL LOCATIONS AND HEIGHTS FOR EACH SIGN TYPE.
- FABRICATOR TO FIELD VERIFY ALL EXISTING CONDITIONS AND THEIR IMPACT ON FINAL SIGN DIMENSIONS PRIOR TO FABRICATION
- SUBSTITUTE TYPEFACES, ARROWS OR SYMBOLS WILL NOT BE ACCEPTED. ALL SYMBOLS TO BE STANDARD F.A.A., A.G.A. DOT, ANSI, ADA SYMBOLS. IF NECESSARY, CONTACT ARCHITECT FOR INFORMATION ON AVAILABILITY. ALL FASTENERS TO BE CONCEALED AND VANDAL RESISTANT UNLESS OTHERWISE NOTED.
- FABRICATOR TO BE RESPONSIBLE FOR PULLING ALL PERMITS AND COORDINATING ALL INSPECTIONS REQUIRED IN CONNECTION WITH THE WORK.
- SIGN LOCATION SYMBOLS IN PLAN ASSIGNED SHOULD BE CROSS REFERENCED TO ELEVATION FOR INDICATION THAT SIGN IS DOUBLE FACED. PROJECTIONS SIGNS ARE ALSO DOUBLE FACED.
- FABRICATOR SHALL BE RESPONSIBLE FOR PREPARATION OF ITS SUBMITTALS AND FILING OF ALL NECESSARY PERMITS AND VARIANCES. (IF APPLICABLE), INCLUDING SUBMITTALS FOR OTHER RELATED REVIEW COMMITTEES FOR THIS PROJECT'S JURISDICTION. TASKS ALSO INCLUDE COORDINATION OF ALL INSPECTIONS REQUIRED IN CONNECTION WITH THE WORK.
- FABRICATOR SHALL BE RESPONSIBLE FOR LAYOUT AND PRODUCTION OF FULL SIZE TEMPLATES FOR ALL DIMENSIONAL LETTERS AND OTHER SPECIALIZED FORMATS. THESE ALSO REQUIRE THE FIELD REVIEW BY OWNER, ARCHITECT AND OTHER DESIGN PROFESSIONALS.
- FOR SIGNS IN WHICH THE MOUNTING LOCATION IS REQUIRED TO BE ON GLASS, FABRICATOR SHALL PROVIDE VINYL SHEET PRECISION MEASURED TO SIZE OF SIGN AND APPLIED TO REVERSE SIDE OF GLASS. THE VINYL COLOR SHALL MATCH THE COLOR OF THE SIGN. THE SIGN AND ITS DOUBLE FACED TAPE ARE TO BE APPLIED TO THE VIEWING SIDE OF GLASS. THE "BACKER" VINYL SHALL BE OPTICALLY POSITIONED, SO NO "BACKER" VINYL IS SEEN.


11 INDICATES SIGN TYPE REF. ELEVATIONS AG51X SERIES

**COLOR LEGEND**

- ALUMINUM ANODIZED
- MATTHEWS "RED" - [7A-2A] PMS-179C
- BRISTOL "BLUE" - [75A-4A] PMS-5483C
- CASTLE KEEP "GREEN" - [62C-4D] PMS-7475C
- WHITE
- WHITE TEXT U.O.N.

**ELEVATION INDEX**

**M H0 ZD**  
**D14**  
**K1 X1 H1**

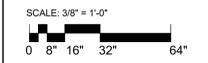

3/10/2020 12:16:03 PM BIM 360/Design of Satellite Concourse/VPS-MLM\_A.rvt



C19-2811- AP  
Construction  
of Satellite  
Concourse 'C'



MIGUEL A MARTIN  
FL AR-98279

SEAL

Revisions

No.	Date	Description
2	09-MAR-2020	ADDENDUM 002

Project No.: **MLM-19672**  
 Designed By: **MAM**  
 Drawn By: **MAM ST CC**  
 Checked By: **MAM MLM**  
 Issue Date: **09-MAR-2020**  
 Drawing Scale: **As indicated**  
 Drawing Title:

**SIGN TYPE  
ELEVATIONS &  
DETAILS**  
BID DOCUMENTS

Drawing No.: **AG514**

**NOTES**

- REFER TO **AL441** FOR PARTITION TYPES
- FOR DOOR TYPES AND SCHEDULES REFER TO SHEET SERIES **A711**
- REFER TO ELECTRICAL, TELECOM AV, AND SIGNAGE DRAWINGS FOR OUTLET INFORMATION.
- REFER TO A SERIES SHEETS FOR DIMENSIONS.
- AREA DESIGNATED FOR FUTURE WORK (NIC), CONTRACTOR SHALL KEEP THIS AREA CLEAR OF ANY BUILT ELEMENTS ABOVE AND/OR BELOW GROUND UNLESS OTHERWISE NOTED WITHIN THE SCOPE OF THIS PROJECT.
- ALL GRADE II BRAILLE IS PRESENTED FOR GRAPHIC REPRESENTATION. CONTRACTOR TO COORDINATE WITH FABRICATOR THAT ACTUAL BRAILLE PRODUCED TRANSLATES THE COPY PROVIDED.
- MESSAGES ILLUSTRATED IN DRAWINGS ARE NOT ACTUAL MESSAGES BUT FOR LAYOUT PURPOSES ONLY. SEE MESSAGE SCHEDULE FOR SPECIFIC MESSAGES. NOTE THAT BID ISSUE OF THE MESSAGE SCHEDULE IS DRAFT LEVEL AND IS TO BE UPDATED BY FABRICATOR THROUGHOUT PROJECT CONSTRUCTION SUBMITTAL PROCESS.
- SIGN LOCATION PLAN SYMBOLS INDICATE GENERAL SIGN LOCATIONS. THEY ARE NOT REPRESENTATIVE OF ACTUAL SIGN SIZES OR OR LOCATIONS. SEE MOUNTING DETAILS FOR MOUNTING LOCATION INFORMATION. CONDUCT PRE-CONSTRUCTION MEETING IN FIELD WITH AIRPORT, AND ARCHITECT TO ESTABLISH PROTOTYPICAL LOCATIONS AND HEIGHTS FOR EACH SIGN TYPE.
- FABRICATOR TO FIELD VERIFY ALL EXISTING CONDITIONS AND THEIR IMPACT ON FINAL SIGN DIMENSIONS PRIOR TO FABRICATION. SUBSTITUTE TYPEFACES, ARROWS OR SYMBOLS WILL NOT BE ACCEPTED. ALL SYMBOLS TO BE STANDARD F.A.A., AIGA, DOT, ANSI, ADA SYMBOLS. IF NECESSARY, CONTACT ARCHITECT FOR INFORMATION ON AVAILABILITY.
- ALL FASTENERS TO BE CONCEALED AND VANDAL RESISTANT UNLESS OTHERWISE NOTED.
- FABRICATOR TO BE RESPONSIBLE FOR PULLING ALL PERMITS AND COORDINATING ALL INSPECTIONS REQUIRED IN CONNECTION WITH THE WORK.
- SIGN LOCATION SYMBOLS IN PLAN ASSIGNED SHOULD BE CROSS REFERENCED TO ELEVATION FOR INDICATION THAT SIGN IS DOUBLE FACED. PROJECTIONS SIGNS ARE ALSO DOUBLE FACED.
- FABRICATOR SHALL BE RESPONSIBLE FOR PREPARATION OF ITS SUBMITTALS AND FILING OF ALL NECESSARY PERMITS AND VARIANCES, (IF APPLICABLE), INCLUDING SUBMITTALS FOR OTHER RELATED REVIEW COMMITTEES FOR THIS PROJECT'S JURISDICTION. TASKS ALSO INCLUDE COORDINATION OF ALL INSPECTIONS REQUIRED IN CONNECTION WITH THE WORK.
- FABRICATOR SHALL BE RESPONSIBLE FOR LAYOUT AND PRODUCTION OF FULL SIZE TEMPLATES FOR ALL DIMENSIONAL LETTERS AND OTHER SPECIALIZED FORMATS. THESE ALSO REQUIRE THE FIELD REVIEW BY OWNER, ARCHITECT AND OTHER DESIGN PROFESSIONALS.
- FOR SIGNS IN WHICH THE MOUNTING LOCATION IS REQUIRED TO BE ON GLASS, FABRICATOR SHALL PROVIDE VINYL SHEET PRECISION MEASURED TO SIZE OF SIGN AND APPLIED TO REVERSE SIDE OF GLASS. THE VINYL COLOR SHALL MATCH THE COLOR OF THE SIGN. THE SIGN AND ITS DOUBLE FACED TAPE ARE TO BE APPLIED TO THE VIEWING SIDE OF GLASS. THE "BACKER" VINYL SHALL BE OPTICALLY POSITIONED, SO NO "BACKER" VINYL IS SEEN.



1t INDICATES SIGN TYPE REF. ELEVATIONS **AG51X** SERIES

**COLOR LEGEND**


- ALUMINUM ANNOXIDIZED
- MATTHEWS "RED" - [7A-2A] PMS-179C
- BRISTOL "BLUE" - [75A-4A] PMS-5483C
- CASTLE KEEP "GREEN" - [62C-4D] PMS-7475C
- WHITE
- WHITE TEXT U.O.N.

**ELEVATION INDEX**

- 
- 
- P X2**

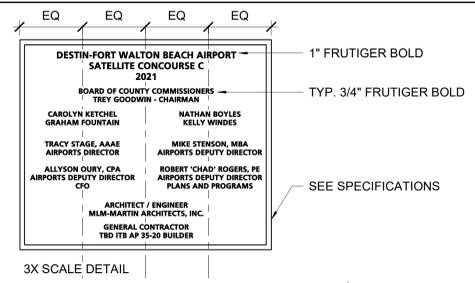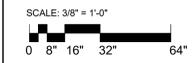

A2 **[P] DEDICATION PLAQUE**  
3/8" = 1'-0"

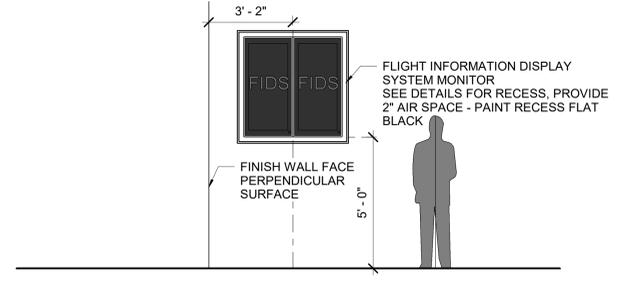

A4 **[X2] FIDS DISPLAY**  
3/8" = 1'-0"

BIM 380/Design of Satellite Concourse/VPS-MLM\_A.rvt

3/10/2020 12:20:16 PM

**KEYNOTES**

- NO. 08 31 13.C01 TYPICAL GALV. MTL. CEILING ACCESS DOOR, PAINT TO MATCH SURROUNDING
- 10 26 13.5250 TYP. 2" BRUSHED ALUMINUM WALL CORNER GUARD.
- 12 36 61.1600 TYP. SOLID SURFACING COUNTERTOPS.



C19-2811- AP Construction of Satellite Concourse 'C'



MIGUEL A MARTIN FL AR-98279

SEAL

Revisions


No.	Date	Description
2	09-MAR-2020	ADDENDUM 002

Project No.: **MLM-19672**  
 Designed By: **MLM, MAM**  
 Drawn By: **ST, CC, DM, CB**  
 Checked By: **MAM**  
 Issue Date: **21-JAN-2020**  
 Drawing Scale: **As indicated**  
 Drawing Title:


**MILLWORK PLAN DETAILS**

BID DOCUMENTS

Drawing No.: **AQ821**

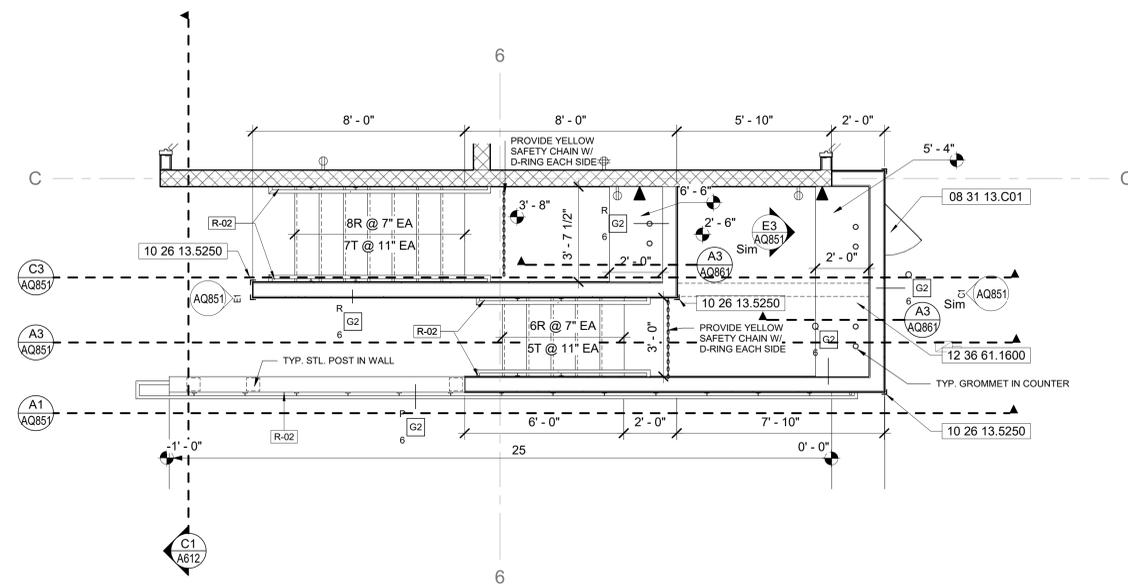


**A1 ENLARGED PLAN - TSA PODIUM**  
3/8" = 1'-0"

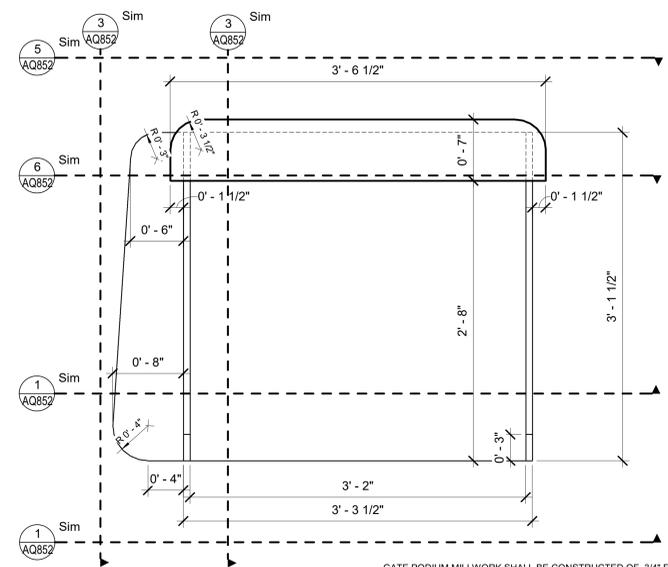

**A3 HOLDING ROOM PODIUM PLAN**  
1 1/2" = 1'-0"


GATE PODIUM MILLWORK SHALL BE CONSTRUCTED OF 3/4" FR MDF BOARDNOM. FR TREATED 2X BLOCKING LAMINATED BY PL1 FINISH FOR ALLEXPPOSED FACES W/ PL2 FINISH FOR ALL EXPOSED SURFACE ON INTERIOR OF DRAWERS AND CABINETS. ALL HORIZONTAL SURFACES (EXCEPT FOR DRAW/ CAB. INTERIORS OR ADJUSTABLE SHELVES) SHALL BE SL1 SOLID SURFACE.



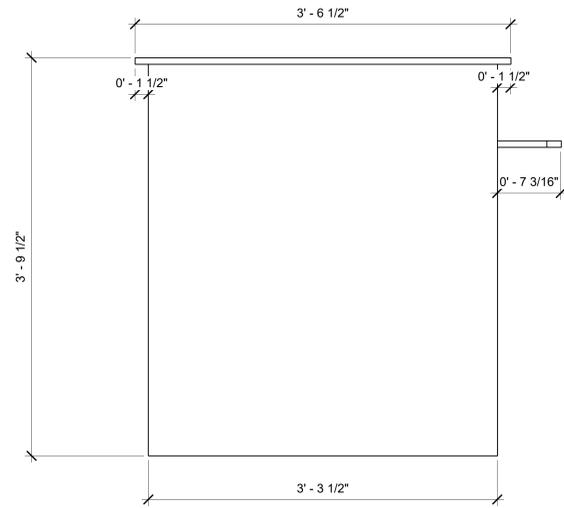


5 Holding Room Podium Elevation Back

1 1/2" = 1'-0"

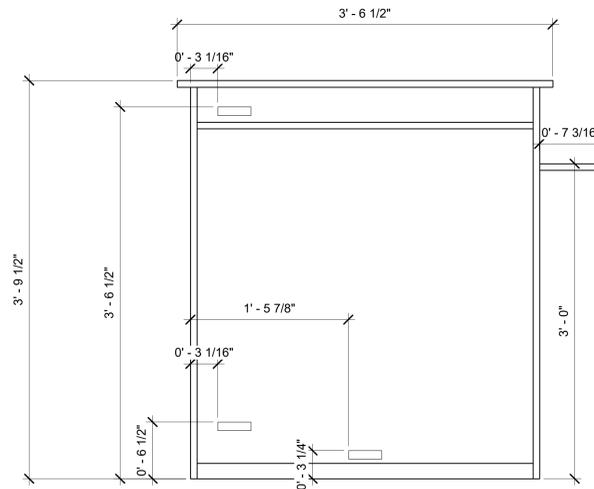


6 Holding Room Podium Section Back

1 1/2" = 1'-0"

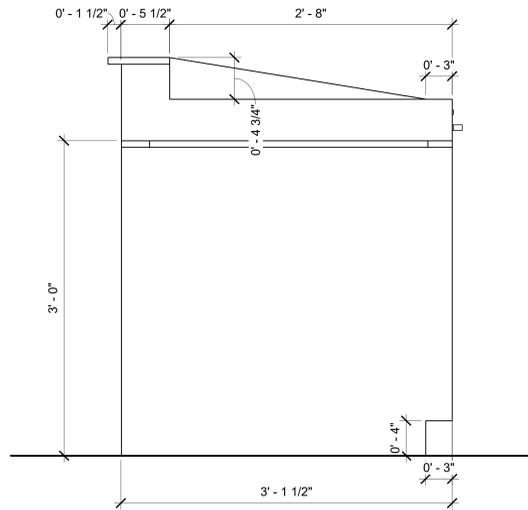


3 Holding Room Podium Elevation Left

1 1/2" = 1'-0"

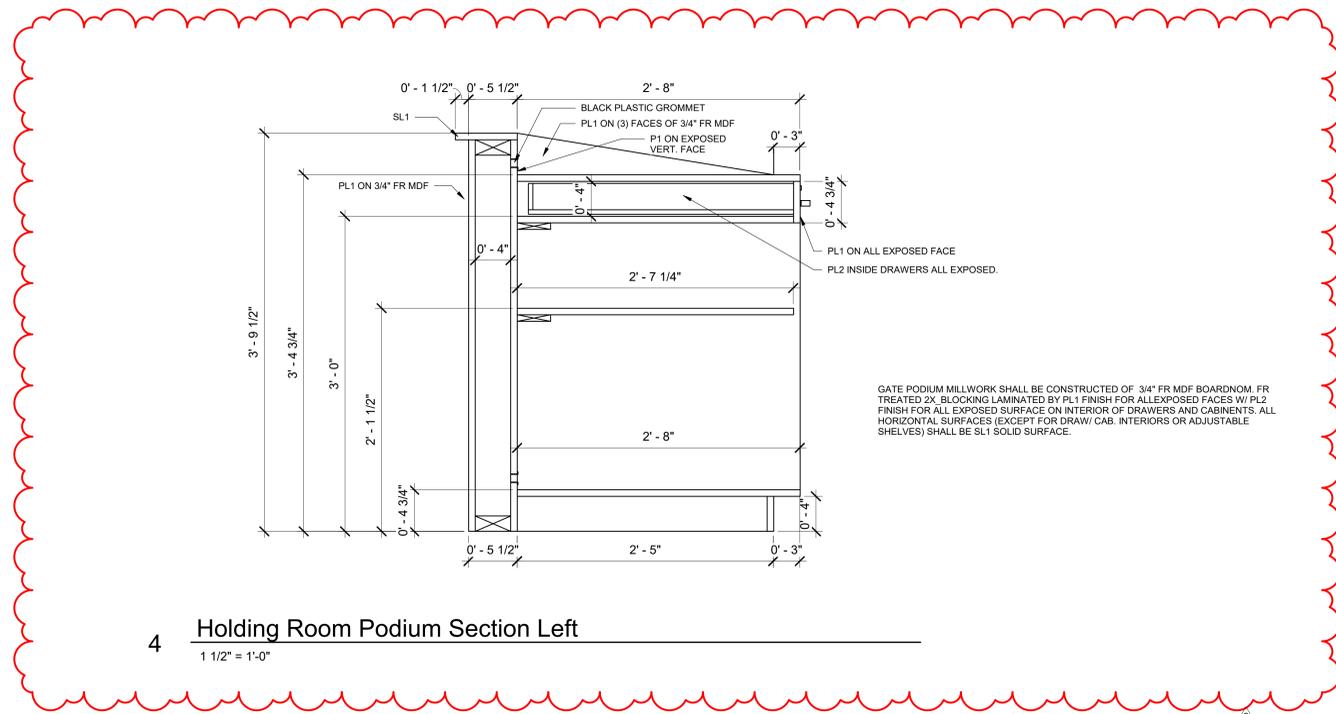


4 Holding Room Podium Section Left

1 1/2" = 1'-0"

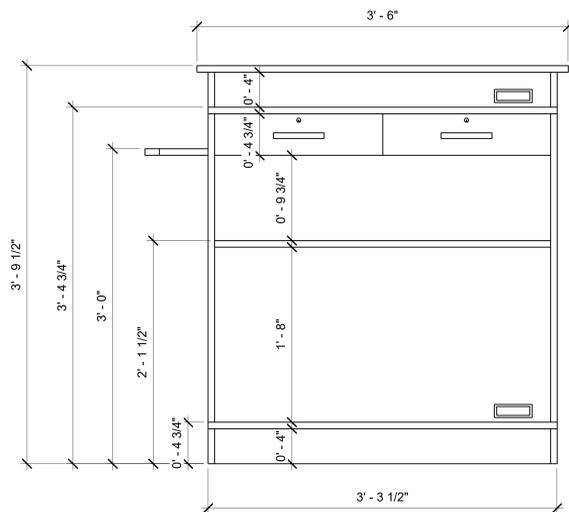

1 Holding Room Podium Elevation Front

1 1/2" = 1'-0"

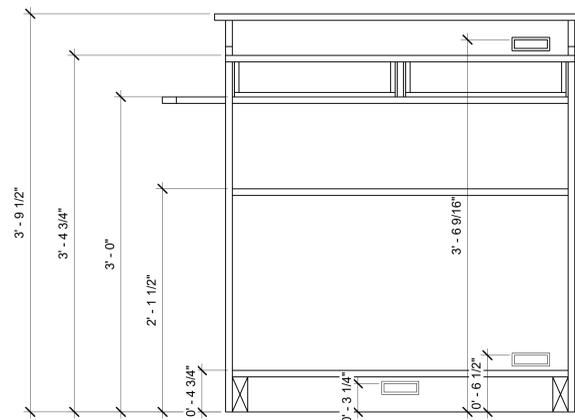

2 Holding Room Podium Section Front

1 1/2" = 1'-0"



C19-2811- AP  
Construction  
of Satellite  
Concourse 'C'



MIGUEL A MARTIN  
FL AR-98279

SEAL

Revisions



No.	Date	Description
2	09-MAR-2020	ADDENDUM 002

Project No.: **MLM-19672**  
 Designed By: **MLM, MAM**  
 Drawn By: **ST, CC, DM, CB**  
 Checked By: **MAM**  
 Issue Date: **21-JAN-2020**  
 Drawing Scale: **1 1/2" = 1'-0"**  
 Drawing Title:

**MILLWORK  
ELEVATION  
DETAILS**  
 BID DOCUMENTS

Drawing No.:

**AQ852**

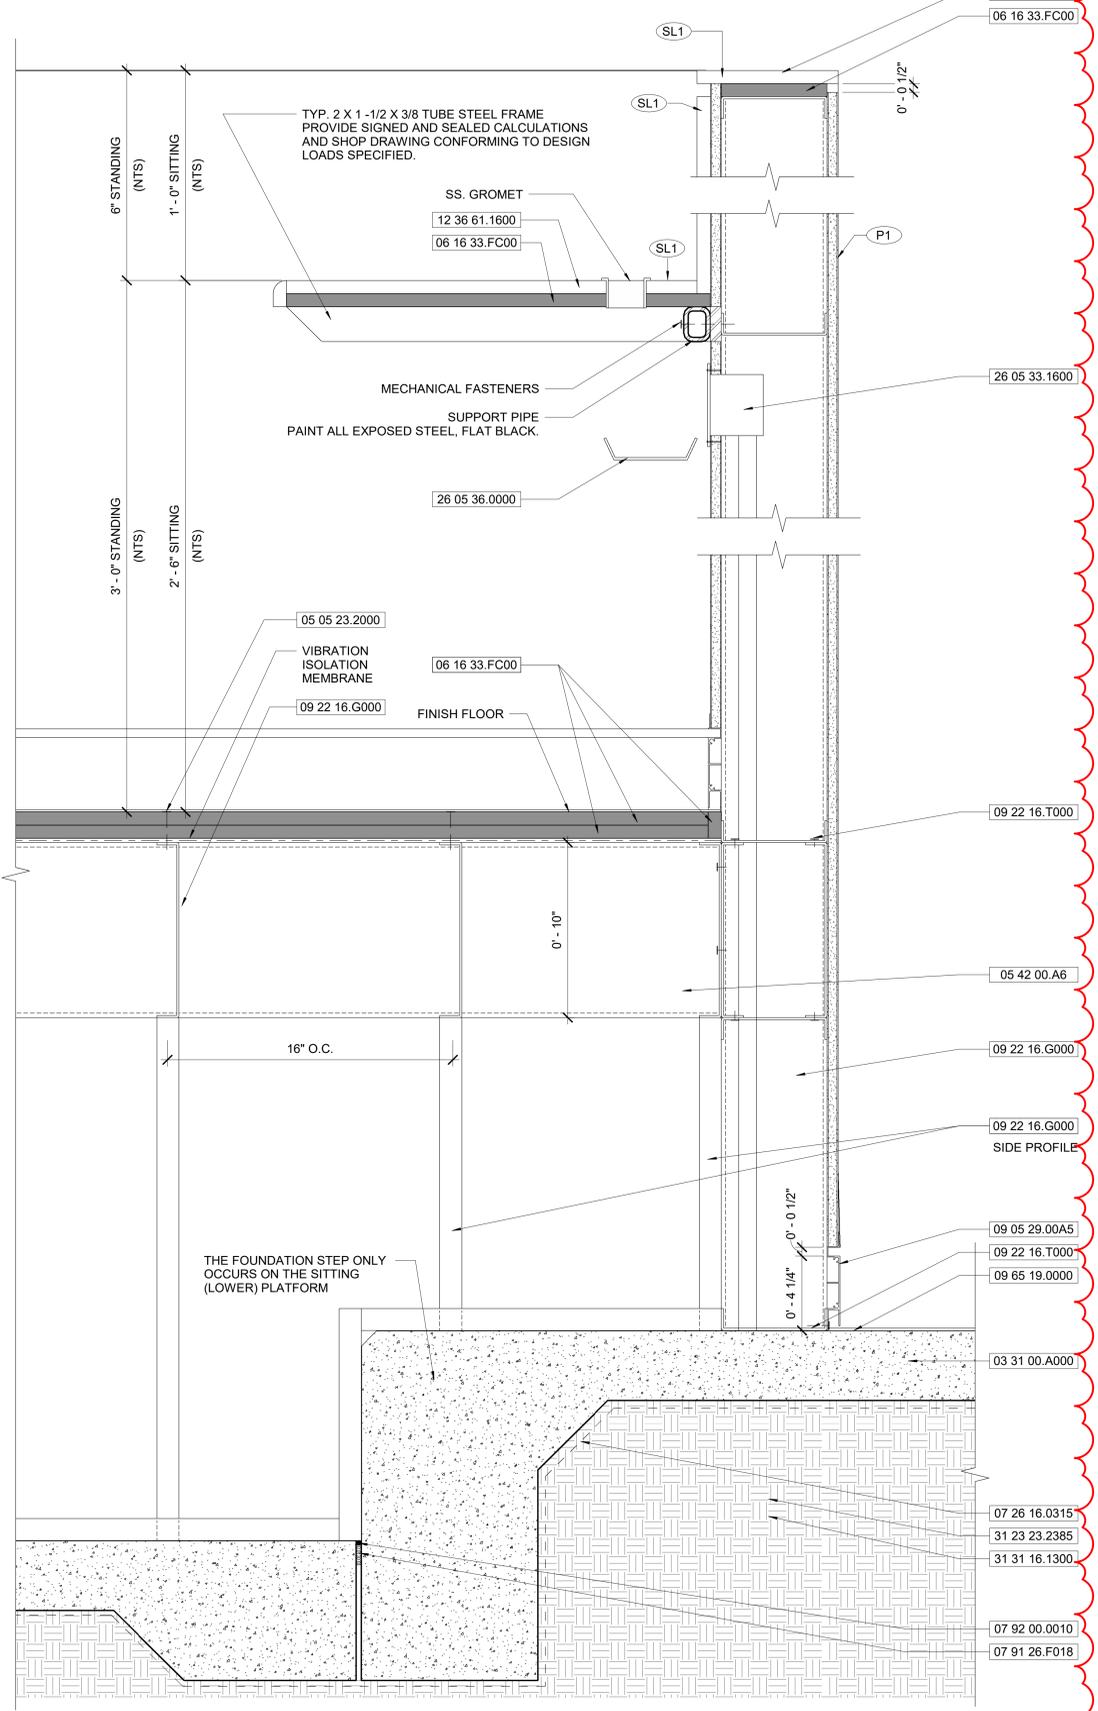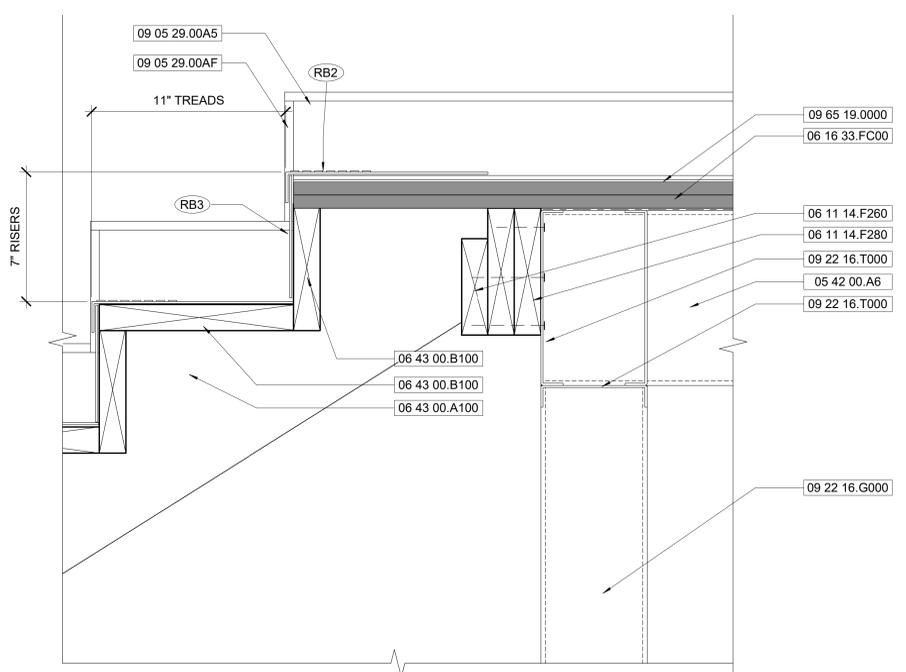

**KEYNOTES**

NO.	DESCRIPTION
03 31 00.A000	TYP. CONCRETE SLABS-ON-GRADE, SEE STRUCTURAL
05 05 23.2000	TYP. STAINLESS STEEL FASTENER(S).
05 42 00.A6	10" *C* JOIST
06 11 14.F260	TYP. 2X6 NOMINAL FIRE RETARDANT WOOD BLOCKING. CONT.
06 11 14.F280	TYP. 2X8 NOMINAL FIRE RETARDANT WOOD BLOCKING. CONT.
06 16 33.FC00	TYP. 3/4" FR PLYWOOD.
06 43 00.A100	TYP. 2X NOMINAL FR TREATED WOOD STRINGER CUT.
06 43 00.B100	TYP. 2X NOMINAL FR TREATED WOOD TREADS AND RISERS.
07 26 16.0315	TYP. 15 MIL BELOW GRADE VAPOR BARRIER.
07 91 26.F018	TYP. 1/2" MINIERAL FIBER JOINT FILLER CONT.
07 92 00.0010	TYP. JOINT SEALANT, CONT.
09 05 29.00A5	TYP. ALUMINUM GYPSUM BOARD REVEAL BASE ACCESSORY.
09 05 29.00AF	TYP. ALUMINUM GYPSUM BOARD 'F' REVEAL ACCESSORY.
09 22 16.G000	TYPICAL 6" GALV. METAL STUD FRAMING @16" OC UNO.
09 22 16.T000	TYPICAL GALV. METAL TRACK RUNNER CONT.
09 65 19.0000	TYP. LUXARY VINYL COMPOSITION TILE, SEE SCHEDULE.
12 36 61.1600	TYP. SOLID SURFACING COUNTERTOPS.
26 05 33.1600	TYP. ELECTRICAL BOX WITH FACEPLATE, COORDINATE FACEPLATE WITH DIV. 26, 27 AND 28.
26 05 36.0000	TYP. CONCEALED S.S. WIRE TRAY SUSPEND FROM COUNTER.
31 23 23.2385	TYP. COMPACTED FILL TO A MIN. OF 85% COMPACTION AS PER ASTM D1557.
31 31 16.1300	TYP. SPRAY TERMITE TOXICANT BARRIER.



C19-2811- AP  
Construction  
of Satellite  
Concourse 'C'



MIGUEL A MARTIN  
FL AR-98279

SEAL

Revisions

No.	Date	Description
2	09-MAR-2020	ADDENDUM 002

Project No.: **MLM-19672**  
 Designed By: **MLM, MAM**  
 Drawn By: **ST, CC, DM, CB**  
 Checked By: **MAM**  
 Issue Date: **21-JAN-2020**  
 Drawing Scale: **3" = 1'-0"**  
 Drawing Title:

**MILLWORK  
SECTION  
DETAILS**  
 BID DOCUMENTS

Drawing No.:  
**AQ861**



**Bid Schedule**  
**ITB AP 35-20 CONSTRUCTION OF SATELLITE CONCOURSE "C" at**  
**VPS Destin – Fort Walton Beach Airport**




Item No.	Item Description	Quantity	Unit	Unit Price	Base Amount	CxA of HVAC (230800) Additional Amount	Add Alternate NO 6 Substitute Ceiling Tile	Deductive Alternate NO 7 Substitute Wall Tile	Seating Allowance	Landscape Allowance	TOTALS
BB	BASE BID: Entry, TSA Support, (SSCP) Security Screening Check Point, Restroom Core 1, Holdroom C1 & C2, Reference Line 0-13	1	1		\$	\$	\$	\$	\$ 50,000.00	\$ 40,000.00	\$
1	ADD ALTERNATE NO 1: Concessions, Holdroom C3, Reference Line 13-17	1	1		\$	\$	\$	N/A	\$ 25,000.00	N/A	\$
2	ADD ALTERNATE NO 2: Concessions, Restroom Core 2, Holdroom C4, Reference Line 17-22	1	1		\$	\$	\$	\$	\$ 25,000.00	N/A	\$
3	ADD ALTERNATE NO 3: Holdroom C5, Reference Line 22-25	1	1		\$	\$	\$	N/A	\$ 25,000.00	N/A	\$
4	ADD ALTERNATE NO 4: Covered Entry Canopy and Structure Only; SLAB IS IN BASE BID	1	1		\$	\$	N/A	N/A	N/A	N/A	\$
5	ADD ALTERNATE NO 5: Outdoor Seating Area (Concessions)	1	1		\$	\$	N/A	N/A	N/A	N/A	\$
<b>TOTALS</b>					<b>\$</b>	<b>\$</b>	<b>\$</b>	<b>\$</b>	<b>\$</b>	<b>\$</b>	

<b>TOTAL AMOUNT BID:</b>	<b>\$</b>
--------------------------	-----------


SIDA FENCE (see Civil)	\$	Cost / LF
SIDA FENCE FOR FULL BUILD SEE B1/G211	\$	~36 LF
SIDA FENCE FOR BASE BID + 2 ALTS SEE A1/G212	\$	~109 LF
SIDA FENCE FOR BASE BID + 1 ALT SEE B1/G212	\$	~234 LF
SIDA FENCE FOR BASE BID SEE D1/G213	\$	~334 LF

\*\*If a contactor would like to have a copy of this bid sheet in Excel format, please email [jdarr@myokaloosa.com](mailto:jdarr@myokaloosa.com) or [dmason@myokaloosa.com](mailto:dmason@myokaloosa.com) to request a copy.\*\*

REFER TO PLAN FOR TIE BEAM ELEVATIONS

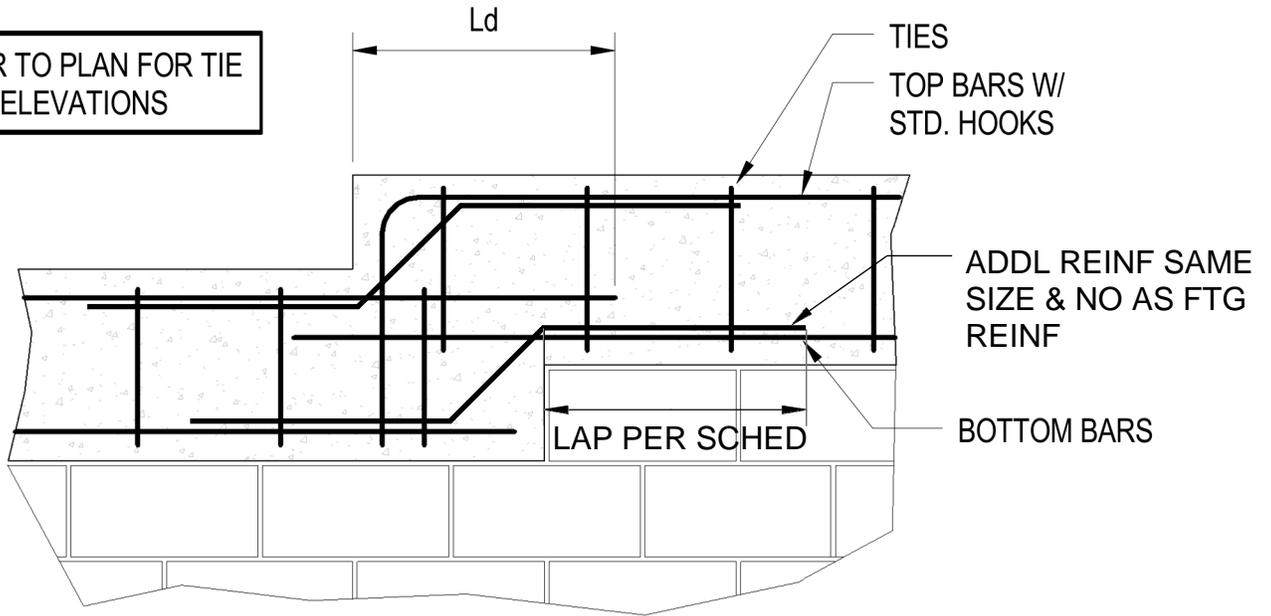

IN-LINE STEP

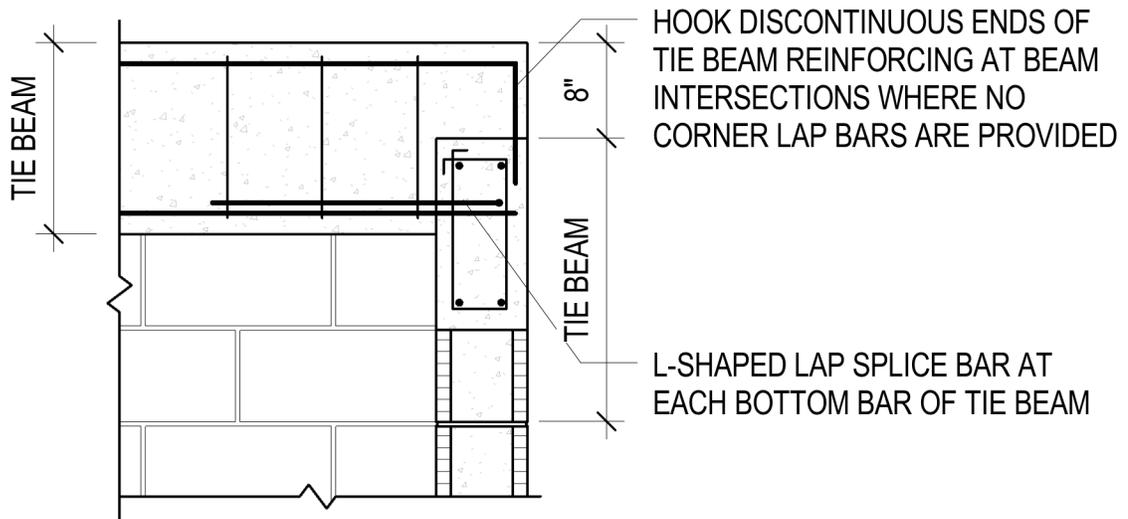

STEP AT BEAM INTERSECTION

TYPICAL STEPPED TIE BEAM DETAIL

3/4" = 1'-0"

Revision:		Project: Construction of Satellite Concourse 'C'	
Supplement to Drawing No.:		TLC Job No.: 719055	Scale: NTS
Date: 03/02/2020		4890 W Kennedy Blvd Suite 250 Tampa, FL 33609 P 813.637.0110 <a href="http://tlc-engineers.com">tlc-engineers.com</a> COA 15	Sketch No.:
Design:			<b>SK0-1</b>
Check:			



**Bid Schedule**  
**ITB AP 35-20 CONSTRUCTION OF SATELLITE CONCOURSE "C" at**  
**VPS Destin - Fort Walton Beach Airport**



Item No.	Item Description	Quantity	Unit	Unit Price	Base Amount	CYA of HVAC (230800) Additional Amount	Add Alternate NO 6 Substitute Ceiling Tile	Deductive Alternate NO 7 Substitute Wall Tile	Seating Allowance	Landscape Allowance	TOTALS
BB	BASE BID: Entry, TSA Support, (SSCP) Security Screening Check Point, Restroom Core 1, Holdroom C1 & C2, Reference Line 0-13	1	1		\$		\$	\$	\$ 50,000.00	\$ 40,000.00	\$
1	ADD ALTERNATE NO 1: Concessions, Holdroom C3, Reference Line 13-17	1	1		\$		\$	N/A	\$ 25,000.00	N/A	\$
2	ADD ALTERNATE NO 2: Concessions, Restroom Core 2, Holdroom C4, Reference Line 17-22	1	1		\$		\$	N/A	\$ 25,000.00	N/A	\$
3	ADD ALTERNATE NO 3: Holdroom C5, Reference Line 22-25	1	1		\$		\$	N/A	\$ 25,000.00	N/A	\$
4	ADD ALTERNATE NO 4: Covered Entry Canopy and Structure Only; SLAB IS IN BASE BID	1	1		\$		N/A	N/A	N/A	N/A	\$
5	ADD ALTERNATE NO 5: Outdoor Seating Area (Concessions)	1	1		\$		N/A	N/A	N/A	N/A	\$
<b>TOTALS</b>					\$	\$	\$	\$	\$	\$	\$
<b>TOTAL AMOUNT BID: \$</b>											

SIDA FENCE (see Civil)	\$	Cost / LF
SIDA FENCE FOR FULL BUILD SEE B1/G211	\$	~36 LF
SIDA FENCE FOR BASE BID + 2 ALTS SEE A1/G212	\$	~109 LF
SIDA FENCE FOR BASE BID + 1 ALT SEE B1/G212	\$	~234 LF
SIDA FENCE FOR BASE BID SEE D1/G213	\$	~334 LF

\*\*If a contractor would like to have a copy of this bid sheet in Excel format, please email jlarri@myokaloosa.com to request a copy.\*\*